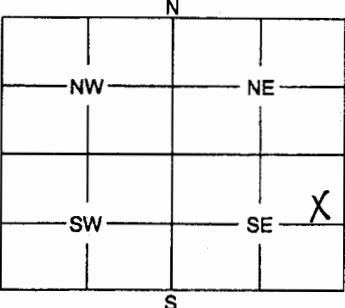


1	LOCATION OF WATER WELL:	Fraction	Section	Number	Township	Number	Range	Number
	County: Sedgwick	SE ¼ NE ¼ SE ¼		11		28		1

Distance and direction from nearest town or city street address of well if located within city?

3727 S. West St., Wichita

2	WATER WELL OWNER: Hampel Oil
	RR #, St. Address, Box #: 3727 S. West St. City, State, ZIP Code : Wichita, KS 67277
	Board of Agriculture, Division of Water Resources Application Number:

3	MARK WELL'S LOCATION WITH AN "X" IN SECTION BOX:	4	DEPTH OF WELL 14.9 ft. BTOC WELL'S STATIC WATER LEVEL 14.7 ft. WELL WAS USED AS: <table border="0"><tr><td>1 Domestic</td><td>5 Public Water Supply</td><td>9 Dewatering</td></tr><tr><td>2 Irrigation</td><td>6 Oil Field Water Supply</td><td>● Monitoring Well</td></tr><tr><td>3 Feedlot</td><td>7 Domestic (Lawn & Garden)</td><td>11 Injection Well</td></tr><tr><td>4 Industrial</td><td>8 Air Conditioning</td><td>12 Other</td></tr></table>	1 Domestic	5 Public Water Supply	9 Dewatering	2 Irrigation	6 Oil Field Water Supply	● Monitoring Well	3 Feedlot	7 Domestic (Lawn & Garden)	11 Injection Well	4 Industrial	8 Air Conditioning	12 Other
1 Domestic	5 Public Water Supply	9 Dewatering													
2 Irrigation	6 Oil Field Water Supply	● Monitoring Well													
3 Feedlot	7 Domestic (Lawn & Garden)	11 Injection Well													
4 Industrial	8 Air Conditioning	12 Other													
		Was a chemical / bacteriological sample submitted to Department? Yes No ☒ If yes, mo/day/yr sample was submitted													
		Water Well Disinfected: Yes No ☒													

5	TYPE OF BLANK CASING USED:										
	<table border="0"><tr><td>1 Steel</td><td>3 RMP (SR)</td><td>5 Wrought</td><td>7 Fiberglass</td><td>9 Other (Specify below)</td></tr><tr><td>● PVC</td><td>4 ABS</td><td>6 Asbestos-Cement</td><td>8 Concrete Tile</td><td></td></tr></table>	1 Steel	3 RMP (SR)	5 Wrought	7 Fiberglass	9 Other (Specify below)	● PVC	4 ABS	6 Asbestos-Cement	8 Concrete Tile	
1 Steel	3 RMP (SR)	5 Wrought	7 Fiberglass	9 Other (Specify below)							
● PVC	4 ABS	6 Asbestos-Cement	8 Concrete Tile								
	Blank casing diameter 2 in. Was casing pulled? Yes ☒ No If yes, how much 15.25' * Casing height above or below land surface 0 in.										

6	GROUT PLUG MATERIAL: 1 Neat cement 2 Cement grout ● Bentonite ● Other Concrete																				
	Grout Plug Intervals: From 0 ft. to 1 ft., From 1 ft. to 15.25 ft., From to ft.																				
	What is the nearest source of possible contamination: <table border="0"><tr><td>1 Septic tank</td><td>6 Seepage pit</td><td>11 Fuel storage</td><td>16 Other (specify below)</td></tr><tr><td>2 Sewer lines</td><td>7 Pit privy</td><td>12 Fertilizer storage</td><td></td></tr><tr><td>3 Watertight sewer lines</td><td>8 Sewage lagoon</td><td>13 Insecticide storage</td><td></td></tr><tr><td>4 Lateral lines</td><td>9 Feedyard</td><td>14 Abandoned water well</td><td></td></tr><tr><td>5 Cess pool</td><td>10 Livestock pens</td><td>15 Oil well/Gas well</td><td></td></tr></table>	1 Septic tank	6 Seepage pit	11 Fuel storage	16 Other (specify below)	2 Sewer lines	7 Pit privy	12 Fertilizer storage		3 Watertight sewer lines	8 Sewage lagoon	13 Insecticide storage		4 Lateral lines	9 Feedyard	14 Abandoned water well		5 Cess pool	10 Livestock pens	15 Oil well/Gas well	
1 Septic tank	6 Seepage pit	11 Fuel storage	16 Other (specify below)																		
2 Sewer lines	7 Pit privy	12 Fertilizer storage																			
3 Watertight sewer lines	8 Sewage lagoon	13 Insecticide storage																			
4 Lateral lines	9 Feedyard	14 Abandoned water well																			
5 Cess pool	10 Livestock pens	15 Oil well/Gas well																			
	Direction from well? How many feet?																				

FROM	TO	PLUGGING MATERIALS
0	1	Native soil
1	15.25	Bentonite (8")

*Drilled out to 15.25'

MW9

KDHE #U2 087 00335

7	CONTRACTOR'S OF LANDOWNER'S CERTIFICATION: This water well was plugged under my jurisdiction and was completed on (mo/day/year) 9/26/2006 and this record is true to the best of my knowledge and belief. Kansas Water Well Contractor's License No. 527 This Water Well Record was completed on (mo/day/year) 10/04/2006 under the business name of Geopcore Inc. by (signature) <i>Don Robb</i>
---	--

INSTRUCTIONS: Use typewriter or ball point pen. Please press firmly and print clearly. Please fill in blanks, underline or circle the correct answers. Send top three copies to Kansas Department of Health and Environment, Bureau of Water, Geology Section, 1000 SW Jackson St., Ste. 420, Topeka, Kansas 66612-1367. Telephone: 785/296-5522. Send one to Water Well Owner and retain one for your records.