

WATER WELL PLUGGING RECORD Form WWC-5P

KSA 82a-1212

ID NO.

1 LOCATION OF WATER WELL:

County:

Fraction

SW 1/4 SW 1/4 SE 1/4

Section Number

10

Township Number

28

Range Number

1

E/W

Distance and direction from nearest town or city street address of well if located within city?

6108 W 38 S

2 WATER WELL OWNER:

m. Baker

RR#, St. Address, Box #:

6108 W 38 S

City, State ZIP Code:

Wichita, KS 67215

Global Positioning Systems (decimal degrees, min. of 4 digits)

Latitude:


Longitude:

Elevation:

Datum:

Data Collection Method:

3 MARK WELL'S LOCATION WITH AN "X" IN SECTION BOX:

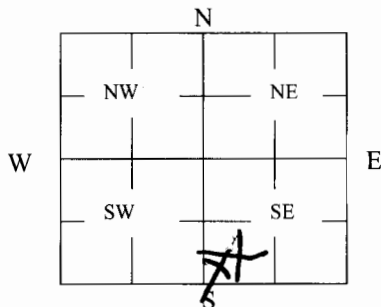

4 DEPTH OF WELL 50 ft.

WELL'S STATIC WATER LEVEL 20 ft

WELL WAS USED AS:

1 Domestic

2 Irrigation

3 Feedlot

4 Industrial

5 Public Water Supply

6 Oil Field Water Supply

7 Domestic (Lawn & Garden)

8 Air Conditioning

9 Dewatering

10 Monitoring

11 Injection Well

12 Other

Was a chemical/bacteriological sample submitted to Department? Yes No X

5 TYPE OF BLANK CASING USED:

1 Steel

2 RMP (SR)

3 Wrought

4 Fiberglass

5 Other (Specify below)

6 PVC

7 ABS

8 Asbestos-Cement

9 Concrete Tile

Blank casing diameter 5 in.

Was casing pulled? Yes X No

If yes, how much 4'

Casing height above or below land surface 48 in.

6 GROUT PLUG MATERIAL:

1 Neat cement

2 Cement grout

3 Bentonite

4 Other

Grout Plug Intervals: From 20 ft. to 4 ft., From ft. to ft., From to ft.

What is the nearest source of possible contamination:

1 Septic tank

2 Seepage pit

3 Fuel Storage

4 Other (specify below)

5 Sewer lines

6 Pit privy

7 Fertilizer storage

8 Watertight sewer lines

9 Sewage lagoon

10 Insecticide storage

11 Lateral lines

12 Feedyard

13 Abandoned water well

Direction from well? West

12 Cess pool

13 Livestock pens

14 Oil well/Gas well

How many feet? 15

FROM	TO	PLUGGING MATERIALS	FROM	TO	PLUGGING MATERIALS
50	20	Sand & Gravel			
20	0	Cement grout			

7 CONTRACTOR'S OR LANDOWNER'S CERTIFICATION: This water well was plugged under my jurisdiction and was completed on (mo/day/year) 3-30-10 and this record is true to the best of my knowledge and belief. Kansas Water Well Contractor's License No. 472. This Water Well Record was completed on (mo/day/year) 3-30-10 under the business name of Beards Pump & Well by (signature)

INSTRUCTIONS: Use typewriter or ballpoint pen. Please press firmly and print clearly. Please fill in blanks, underline or circle the correct answers. Send top three copies to Kansas Department of Health and Environment, Bureau of Water, Geology Section, 1000 SW Jackson St., Ste. 420, Topeka, Kansas 66612-1367. Telephone: 785/296-5522. Send one to Water Well Owner and retain one for your records. Visit us at <http://www.kdheks.gov/geo/waterwells>.