

County: Sedgwick Fraction SE SE NW NE Sec. 6 T 28 S R 1 E/W

CORRECTION(S) TO WATER WELL COMPLETION RECORD (WWC-5)
(to rectify lacking or incorrect information)

Owner: Bishop, Nichole

Location was listed as:

Section-Township-Range: 30-27s-1w

Fraction (1/4 1/4 1/4): SW NW SE NE

Location changed to:

6-28s-1w

SE SE NW NE

Other changes: Initial statements: long-lat for this KOLAR well do not match
address at house.

Changed to: _____

Comments: _____

Verification method: Google maps issued new long-lat

initials: DAU date: July 22, 2014

Submitted by: Kansas Geological Survey, Data Resources Library, 1930 Constant Ave., Lawrence, KS 66047-3726
to: Kansas Dept of Health & Environment, Bureau of Water, 1000 SW Jackson, Suite 420, Topeka, KS 66612-1367.




WATER WELL RECORD Form WWC-5 1201060

Division of Water Resources App. No. Well ID

Original Record Correction Change in Well Use

| | | | | |
|---|---------------------------------|-----------------------------|----------------------------------|---|
| 1 LOCATION OF WATER WELL: County: Sedgwick | Fraction SW ¼ NW ¼ SE ¼ NE ¼ | Section Number 30 | Township Number T 27 S | Range Number R 1 <input type="checkbox"/> E <input checked="" type="checkbox"/> W |
|---|---------------------------------|-----------------------------|----------------------------------|---|

| | |
|--|--|
| 2 WELL OWNER: Last Name: BISHOP First: NICHOLE Business: Address: 10810 W HADDEN ST Address: City: WICHITA State: KS ZIP: 67215 | Street or Rural Address where well is located (if unknown, distance and direction from nearest town or intersection): If at owner's address, check here: <input checked="" type="checkbox"/> |
|--|--|

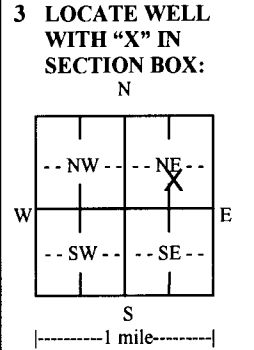

4 DEPTH OF COMPLETED WELL: **120** ft.

Depth(s) Groundwater Encountered: 1) **22** ft.
2) ft. 3) ft., or 4) Dry Well

WELL'S STATIC WATER LEVEL: **22** ft.
 below land surface, measured on (mo-day-yr).....
 above land surface, measured on (mo-day-yr) **3/23/2014**

Pump test data: Well water was ft.
after hours pumping gpm
Well water was ft.
after hours pumping gpm

Estimated Yield: **25** gpm
Bore Hole Diameter: **12** in. to **120** ft. and
..... in. to ft.

5 Latitude: **37.674360**(decimal degrees)
Longitude: **97.466937**(decimal degrees)
Datum: WGS 84 NAD 83 NAD 27
Source for Latitude/Longitude:
 GPS (unit make/model:)
(WAAS enabled? Yes No)
 Land Survey Topographic Map
 Online Mapper:

6 Elevation: **1313**ft. Ground Level TOC
Source: Land Survey GPS Topographic Map
 Other **KOLAR**

7 WELL WATER TO BE USED AS:

| | | |
|---|--|---|
| 1. Domestic: <input type="checkbox"/> Household <input checked="" type="checkbox"/> Lawn & Garden <input type="checkbox"/> Livestock | 5. <input type="checkbox"/> Public Water Supply: well ID | 10. <input type="checkbox"/> Oil Field Water Supply: lease |
| 2. <input type="checkbox"/> Irrigation | 6. <input type="checkbox"/> Dewatering: how many wells? | 11. Test Hole: well ID |
| 3. <input type="checkbox"/> Feedlot | 7. <input type="checkbox"/> Aquifer Recharge: well ID | <input type="checkbox"/> Cased <input type="checkbox"/> Uncased <input type="checkbox"/> Geotechnical |
| 4. <input type="checkbox"/> Industrial | 8. <input type="checkbox"/> Monitoring: well ID | 12. Geothermal: how many bores? |
| | 9. Environmental Remediation: well ID | a) Closed Loop <input type="checkbox"/> Horizontal <input type="checkbox"/> Vertical |
| | <input type="checkbox"/> Air Sparge <input type="checkbox"/> Soil Vapor Extraction | b) Open Loop <input type="checkbox"/> Surface Discharge <input type="checkbox"/> Inj. of Water |
| | <input type="checkbox"/> Recovery <input type="checkbox"/> Injection | 13. <input type="checkbox"/> Other (specify): |

Was a chemical/bacteriological sample submitted to KDHE? Yes No If yes, date sample was submitted:

Water well disinfected? Yes No

8 TYPE OF CASING USED: Steel PVC Other CASING JOINTS: Glued Clamped Welded Threaded

Casing diameter **5** in. to **120** ft., Diameter in. to ft., Diameter in. to ft.
Casing height above land surface **16** in. Weight **160** lbs./ft. Wall thickness or gauge No. **26**

TYPE OF SCREEN OR PERFORATION MATERIAL:
 Steel Stainless Steel Fiberglass PVC Other (Specify)

Brass Galvanized Steel Concrete tile None used (open hole)

SCREEN OR PERFORATION OPENINGS ARE:
 Continuous Slot Mill Slot Gauze Wrapped Torch Cut Drilled Holes Other (Specify)

Louvered Shutter Key Punched Wire Wrapped Saw Cut None (Open Hole)

SCREEN-PERFORATED INTERVALS: From **90** ft. to **120** ft., From ft. to ft., From ft. to ft.
GRAVEL PACK INTERVALS: From **24** ft. to **120** ft., From ft. to ft., From ft. to ft.

9 GROUT MATERIAL: Neat cement Cement grout Bentonite Other

Grout intervals: From **4** ft. to **24** ft., From ft. to ft., From ft. to ft.

Nearest source of possible contamination:

| | | | | |
|--|--|--|---|---|
| <input type="checkbox"/> Septic Tank | <input type="checkbox"/> Lateral Lines | <input type="checkbox"/> Pit Privy | <input type="checkbox"/> Livestock Pens | <input type="checkbox"/> Insecticide Storage |
| <input type="checkbox"/> Sewer Lines | <input type="checkbox"/> Cess Pool | <input type="checkbox"/> Sewage Lagoon | <input type="checkbox"/> Fuel Storage | <input type="checkbox"/> Abandoned Water Well |
| <input checked="" type="checkbox"/> Watertight Sewer Lines | <input type="checkbox"/> Seepage Pit | <input type="checkbox"/> Feedyard | <input type="checkbox"/> Fertilizer Storage | <input type="checkbox"/> Oil Well/Gas Well |
| <input type="checkbox"/> Other (Specify) | | | | |

Direction from well? **S** Distance from well? **26** ft.

| 10 FROM | TO | LITHOLOGIC LOG | FROM | TO | LITHO. LOG (cont.) or PLUGGING INTERVALS |
|---------------|-----|----------------|------|----|--|
| 0 | 3 | SOIL | | | |
| 3 | 16 | CLAY | | | |
| 16 | 44 | FINE SAND | | | |
| 44 | 76 | CLAY | | | |
| 76 | 85 | FINE SAND | | | |
| 85 | 96 | CLAY-MED-SAND | | | |
| 96 | 120 | MEDIUM SAND | | | |
| Notes: | | | | | |

11 CONTRACTOR'S OR LANDOWNER'S CERTIFICATION: This water well was constructed, reconstructed, or plugged under my jurisdiction and was completed on (mo-day-year) **3/24/2014** and this record is true to the best of my knowledge and belief. Kansas Water Well Contractor's License No. **611** This Water Well Record was completed on (mo-day-year) **4/22/2014** under the business name of **Chase Drilling**