


## Division of Water Resources App. No.

Check: ☐ White Copy, ☐ Blue Copy, ☐ Pink Copy



# Kansas Water Wells

Statewide View | Zoom to Location | Filter Wells | Label Wells | Classify Wells | Download Wells | Print to PDF | Clear Highlight | Help

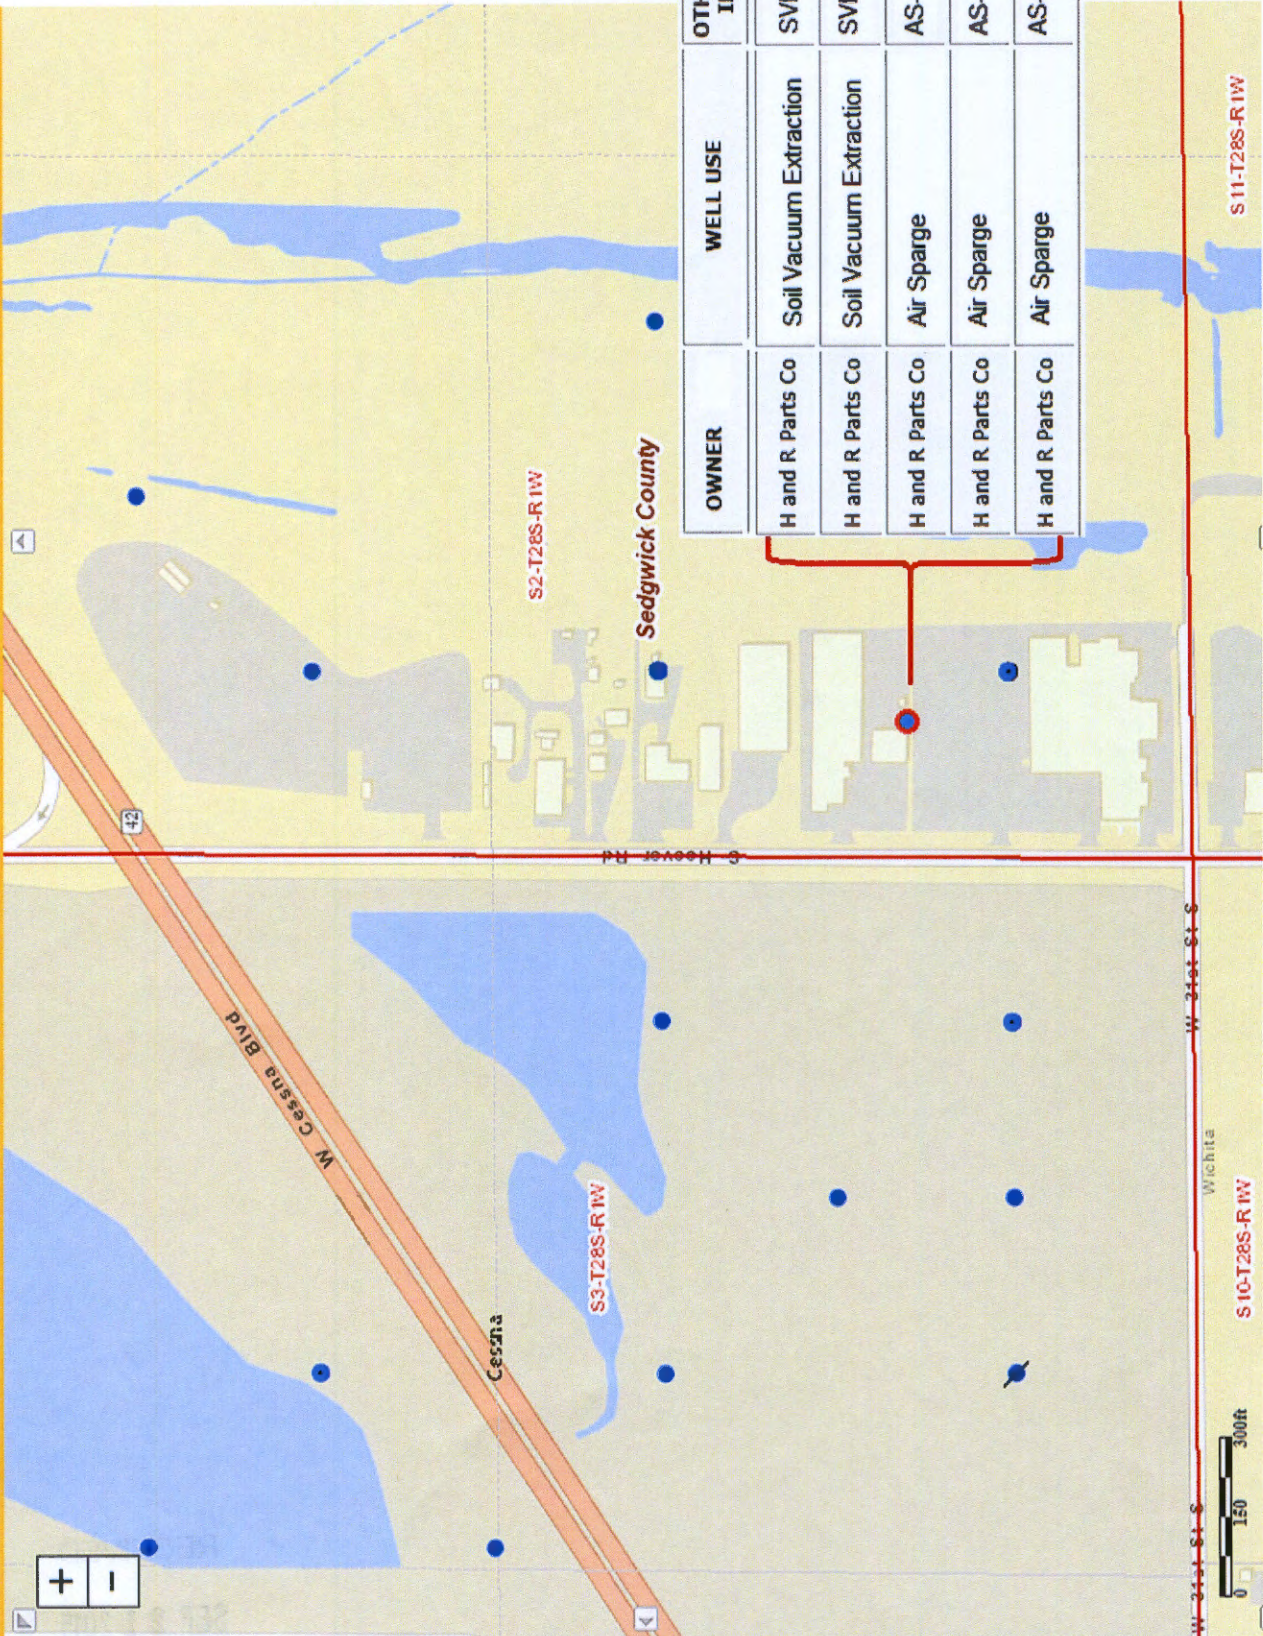

OWNER	WELL USE	OTHER ID
H and R Parts Co	Soil Vacuum Extraction	SVE-1
H and R Parts Co	Soil Vacuum Extraction	SVE-2
H and R Parts Co	Air Sparge	AS-1
H and R Parts Co	Air Sparge	AS-2
H and R Parts Co	Air Sparge	AS-3