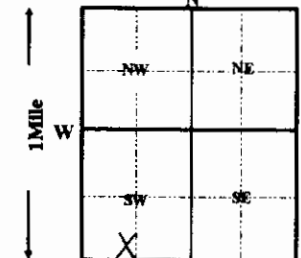


1 LOCATION OF WATER WELL:		FRACTION		Section Number		Township Number		Range Number	
Sedgwick		SE 1/4 SW 1/4 SW 1/4		8		T 28 S		R 1W E/W	
Distance and direction from nearest town or city street address of well if located within city?									
10008 York Wichita, Kansas									
WATER WELL OWNER: KLAUSMEYER, Don RES. ST. ADDRESS, BOX #: 716 N. 119th W., #116 CITY, STATE, ZIP CODE: Wichita, Kansas									
Board of Agriculture, Division of Water Resource									
Application Number:									
LOCATE WELL'S LOCATION WITH AN "X" IN SECTION BOX: 		4 DEPTH OF COMPLETED WELL 45 ft. ELEVATION: Depth(s) groundwater Encountered 1 ft. 2 ft. 3 ft. WELL'S STATIC WATER LEVEL 25 FT. BELOW LAND SURFACE MEASURED ON mo/day/yr 05/08/1998 Pump test data: Well water was ft. after hours pumping gpm Est. Yield gpm: Well water was ft. after hours pumping gpm Bore Hole Diameter 12 in. to 45 ft. and in. to ft. WELL WATER TO BE USED AS: 1 Domestic 3 Feedlot 5 Public water supply 8 Air conditioning 11 Injection well 2 Irrigation 4 Industrial 6 Oil field water supply 9 Dewatering 12 Other (Specify below) 7 Lawn and garden only 10 Monitoring well Was a chemical/bacteriological sample submitted to Department? Yes No ☒ ; If yes, mo/day/yr sample was submitted Water Well Disinfected? Yes ☒ No							
5 TYPE OF CASING USED:									
1 Steel 3 RMP (SR)		5 Wrought iron		8 Concrete tile		CASING JOINTS:		Glued ☒ Clamped	
2 PVC 4 ABS		6 Asbestos-Cement		9 Other (Specify below)				Welded	
		7 Fiberglass		SDR-26				Threaded	
Blank casing Diameter 5 in. to 25 ft., Dia in. to ft., Dia in. to ft.									
Casing height above land surface 12 in., weight 2.35 lbs. / ft. Wall thickness or gauge No. .214									
TYPE OF SCREEN OR PERFORATION MATERIAL:									
1 Steel 3 Stainless Steel		5 Fiberglass		8 RMP (SR)		11 other (specify)			
2 Brass 4 Galvanized steel		6 Concrete tile		9 ABS		12 None used (open hole)			
SCREEN OR PERFORATION OPENING ARE:									
1 Continuous slot 3 Mill slot		5 Gauzed wrapped		8 Saw cut		11 None (open hole)			
2 Louvered shutter 4 Key punched		6 Wire wrapped		9 Drilled holes					
		7 Torch cut		10 Other (specify)					
SCREEN-PERFORATION INTERVALS: from 25 ft. to 45 ft., From ft. to ft.									
GRAVEL PACK INTERVALS: from 24 ft. to 45 ft., From ft. to ft.									
6 GROUT MATERIAL: 1 Neat cement 2 Cement grout 3 Bentonite 4 Other									
Grout Intervals: From 4 ft. to 24 ft. From ft. to ft. From ft. to ft.									
What is the nearest source of possible contamination:									
1 Septic tank 4 Lateral lines		7 Pit privy		10 Livestock pens		14 Abandon water well			
2 Sewer lines 5 Cess pool		8 Sewage lagoon		11 Fuel storage		15 Oil well/Gas well			
3 Watertight sewer lines 6 Seepage pit		9 Feedyard		12 Fertilizer storage		16 Other (specify below)			
				13 Insecticide storage		None Apparent			
Direction from well? How many feet?									
FROM TO		LITHOLOGIC LOG		FROM TO		PLUGGING INTERVALS			
0 3		topsoil							
3 17		fine sand							
17 29		fine sand							
29 45		medium sand							
7 CONTRACTOR'S OR LANDOWNER'S CERTIFICATION: This water well was (1) constructed, (2) reconstructed, or (3) plugged under my jurisdiction and was completed on (mo/day/year) 05/08/1998 and this record is true to the best of my knowledge and belief. Kansas Water Well Contractor's License No. 236 This Water Well Record was completed on (mo/day/yr) 05/11/98 Under the business name of Harp Well & Pump Service, Inc. by (signature) Todd S. Harp									