

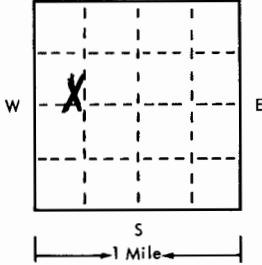
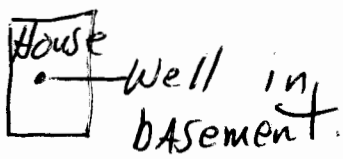
USE TYPEWRITER OR BALL
POINT PEN-PRESS FIRMLY,
PRINT CLEARLY.

WATER WELL RECORD
KSA 82a-1201-1215

T R EW sec 1/4 1/4 1/4 No.

Kansas State Dept. Of Health
(Water Well Contractors)
Farbes-Bldg. 740
Topeka, Kansas 66620

SW NW NE SW

1 Location of well:	County: <u>Sedg.</u>	Township name: <u>WACO</u>	Fraction: <u>SE 1/4 NW 1/4</u>	Section number: <u>10 TEN</u>	Town number: <u>28 S</u>	Range number: <u>1 W</u>
Distance and direction from nearest town or city:				3 Owner of well: <u>Robt Reyes</u>		
Street address of well location if in city: <u>3701 Fairlawn Wichita KS.</u>				Address: <u>3100 So 145 E. Wichita KS.</u>		
Locate with "X" in section below: 				Sketch map: 		
4 Well depth: <u>50</u> ft. Date of completion: <u>12/8</u>				Well diameter: <u>5</u> in.		
5 ☐ Cable tool ☒ Rotary ☐ Driven ☐ Dug				☐ Hollow rod ☐ Jetted ☐ Bored ☐ Reverse rotary		
6 Use: ☒ Domestic ☐ Public supply ☐ Industry				☐ Irrigation ☐ Air conditioning ☐ Commercial		
☐ Test well						
7 Casing: Material: <u>EMP</u> Height: above/below				Threading: ☐ Welded ☒ Surface <u>12</u> in.		
Diam. <u>5</u> in. to <u>50</u> ft. depth				Weight: <u>150</u> lbs./ft. <u>100</u>		
☐ Drive shoe? ☐ Yes ☒ No						
8 Screen: <u>SunFloer</u>				Type: <u>PLASTIC</u> Dia. <u>5"</u>		
Slot/gauze: <u>1/8</u> Length: <u>10'</u>				Set between: <u>40</u> ft. and <u>50</u> ft.		
Fittings: <u>36</u>				Gravel pack: ☒ Yes ☐ No Size range of material: <u>36</u>		
9 Static water level: <u>28</u> ft. below land surface Date: <u>12/8</u>						
10 Pumping level below land surface:				ft. after <u>4 HPM</u> pumping g.p.m.		
ft. after <u>4 HPM</u> pumping g.p.m.				Estimated maximum yield: <u>80</u> g.p.m.		
11 Water sample submitted: ☐ Yes ☒ No Date: _____						
12 Well head completion: ☐ Pitless adapter <u>12</u> inches above grade						
13 Well grouted? ☒ Yes ☐ No				Depth: From <u>0</u> ft. to <u>13 ft. 6 in.</u>		
14 Nearest source of possible contamination: <u>NONE</u>				ft. _____ Direction: _____ Type: _____		
Well disinfected upon completion? ☒ Yes ☐ No						
15 Pump: ☒ Not installed				Manufacturer's name: _____		
Model number: _____ HP: _____ Volts: _____				Length of drop pipe: _____ ft. capacity: _____ g.m.p.		
Type: ☐ Submersible ☐ Turbine				☐ Jet ☐ Reciprocating		
☐ Centrifugal ☐ Other						
16 Remarks: elevation				17 Water well contractor's certification:		
Topography: ☐ Hill ☐ Slope ☒ Upland ☐ Valley				This well was drilled under my jurisdiction and this report is true to the best of my knowledge and belief.		
				Business name: <u>Weninger Pely</u> License No. <u>318</u>		
				Address: <u>21 Colwich KS</u>		
				Signature: <u>James Weninger</u> Date: <u>12/8</u>		
				Authorized representative		

Forward the white, blue and pink copies to the Kansas State Dept. Of Health.

Form WWC-5

28 1W 10 SE SW NW