

State


WATER WELL RECORD Form WWC-5

Original Record Correction Change in Well Use

Division of Water Resources App. No. Well ID

1 LOCATION OF WATER WELL: County: Sedgewick Fraction: N 1/4 S W 1/4 NE 1/4 SE 1/4 Section Number: 7 Township Number: T 28 S Range Number: R 1 E W

2 WELL OWNER: Last Name: Kucera First: Tony Street or Rural Address where well is located: 10627 W. 35th Court S, Wichita, KS 67215

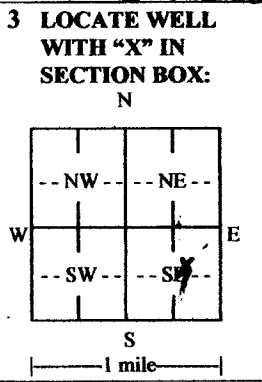

4 DEPTH OF COMPLETED WELL: 55 ft. Depth(s) Groundwater Encountered: 1) 24 ft. WELL'S STATIC WATER LEVEL: 24 ft. below land surface, measured on (mo-day-yr) 3/24/15

5 Latitude: 37.6263595 Longitude: 97.463873 Datum: WGS 84 NAD 83 Source for Latitude/Longitude: GPS (unit make/model): Land Survey Topographic Map Online Mapper

6 Elevation: Ground Level TOC Source: Land Survey GPS Topographic Map Other

7 WELL WATER TO BE USED AS: 1. Domestic: Household, Lawn & Garden, Livestock, Irrigation, Feedlot, Industrial. 5. Public Water Supply: well ID. 6. Dewatering: how many wells? 7. Aquifer Recharge: well ID. 8. Monitoring: well ID. 9. Environmental Remediation: well ID. 10. Oil Field Water Supply: lease. 11. Test Hole: well ID. 12. Geothermal: how many bores? 13. Other (specify):

Was a chemical/bacteriological sample submitted to KDHE? No If yes, date sample was submitted: Water well disinfected? Yes No

8 TYPE OF CASING USED: Steel PVC Other CASING JOINTS: Glued Clamped Welded Threaded Casing diameter: 5 in. to 55 ft. Diameter: 12 in. to 160 lbs./ft. Wall thickness or gauge No. 26

TYPE OF SCREEN OR PERFORATION MATERIAL: Steel Stainless Steel Fiberglass PVC Brass Galvanized Steel Concrete tile None used (open hole) SCREEN OR PERFORATION OPENINGS ARE: Continuous Slot Mill Slot Gauze Wrapped Torch Cut Drilled Holes Other (Specify) Louvered Shutter Key Punched Wire Wrapped Saw Cut None (Open Hole) SCREEN-PERFORATED INTERVALS: From 35 ft. to 58 ft. GRAVEL PACK INTERVALS: From 24 ft. to 55 ft.

9 GROUT MATERIAL: Neat cement Cement grout Bentonite Other Grout Intervals: From 4 ft. to 24 ft. Nearest source of possible contamination: Septic Tank Lateral Lines Pit Privy Livestock Pens Insecticide Storage Sewer Lines Cess Pool Sewage Lagoon Fuel Storage Abandoned Water Well Watertight Sewer Lines Seepage Pit Feedyard Fertilizer Storage Oil Well/Gas Well Direction from well? North Distance from well? 22 ft.

Table with columns: 10 FROM, TO, LITHOLOGIC LOG, FROM, TO, LITHO. LOG (cont.) or PLUGGING INTERVALS. Data rows show depth intervals from 0 to 51 feet.

Notes:

11 CONTRACTOR'S OR LANDOWNER'S CERTIFICATION: This water well was constructed, reconstructed, or plugged under my jurisdiction and was completed on (mo-day-year) 3-24-15 and this record is true to the best of my knowledge and belief. Kansas Water Well Contractor's License No. 6011 This Water Well Record was completed on (mo-day-year) 4-12-15 under the business name of Chocoma Drilling