


WATER WELL RECORD Form WWC-5 KSA 82a-1212

1 LOCATION OF WATER WELL: FRACTION SECTION NUMBER TOWNSHIP NUMBER RANGE NUMBER
Sedgwick NE 1/4 NW 1/4 NW 1/4 24 T 28 S R 1W E/W

Distance and direction from nearest town or city street address of well if located within city?
4805 S. Kessler Wichita, Kansas

2 WATER WELL OWNER: BALTHAOR, Maralene Board of Agriculture, Division of Water Resource
RR#,ST. ADDRESS,BOX #: 4805 S. Kessler Application Number:
CITY, STATE: Wichita, Kansas ZIP CODE:

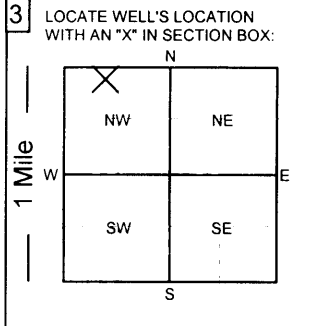

3 LOCATE WELL'S LOCATION WITH AN 'X' IN SECTION BOX: 4 DEPTH OF COMPLETED WELL: 50 ft. ELEVATION:
WELL'S STATIC WATER LEVEL 15 FT. BELOW LAND SURFACE MEASURED ON mo/day/yr: 12/15/15
WELL WATER TO BE USED AS: 1. Domestic 3. Feedlot 5. Public water supply 7. Lawn and garden only 9. Dewatering 11. Injection well
12. Other (Specify below)

5 TYPE OF CASING USED: 1. Steel 2. PVC 3. RPM (SR) 4. ABS 5. Wrought Iron 6. Asbestos-Cement 7. Fiberglass 8. Concrete tile 9. Other (Specify below) CASING JOINTS: Glued Threaded
Blank casing diameter 5 in. to 25 ft., Dia. in. to ft., Dia. in. to ft.
Casing height above land surface: 12 in., Weight: 2.35 lbs. / ft. Wall thickness or gauge No. .214
TYPE OF SCREEN OR PERFORATION MATERIAL: 1. Steel 2. Brass 3. Stainless Steel 4. Galvanized 5. Fiberglass 6. Concrete Tile 7. PVC 8. RMP (SR) 9. ABS 10. Asbestos-Cement 11. Other (specify) 12. None used (open hole)
SCREEN OR PERFORATION OPENINGS ARE: 1. Continuous slot 2. Louvered shutter 3. Mill slot 4. Key punched 5. Gauzed wrapped 6. Wire wrapped 7. Torch cut 8. Saw cut 9. Drilled holes 10. Other (specify) 11. None (open hole)
SCREEN - PERFORATION INTERVAL From 25 ft. to 50 ft., From ft. to ft., From ft. to ft., From ft. to ft.
GRAVEL PACK INTERVALS: From 24 ft. to 50 ft., From ft. to ft., From ft. to ft., From ft. to ft.

6 GROUT MATERIALS: 1. Neat cement 2. Cement Grout 3. Bentonite Other bentonite hole plug
Grout Intervals: From 4 ft. to 24 ft., From ft. to ft., From ft. to ft.
What is the nearest source of possible contamination: 1. Septic tank 2. Sewer lines 3. Watertight sewer line 4. Lateral lines 5. Cess Pool 6. Seepage pit 7. Pit privy 8. Sewage lagoon 9. Feed yard 10. Livestock pens 11. Fuel storage 12. Fertilizer storage 13. Insecticide storage 14. Abandon water well 15. Oil well/Gas well 16. Other (specify below)
Direction from well? West How many feet? 50 ft. plus

Table with columns for From, To, LITHOLOGIC LOG, From, To, LITHOLOGIC LOG. Rows include: 0-3 topsoil, 3-17 clay, 17-35 fine sand, 35-50 medium sand.

7 Contractor's or Landowner's Certification: This water well was 1. constructed 2. reconstructed or 3. plugged under my jurisdiction and
was completed on (mo/day/year) 12/15/15 and this record is true to the best of my knowledge and belief.
Kansas Water Well Contractor's License No. 236 This water well record was completed on (mo/day/year) 12/17/15
under the business name of Harp Well and Pump Service by (signature) Todd S. Harp