


**WATER WELL RECORD Form WWC-5 KSA 82a-1212**

<b>1</b> LOCATION OF WATER WELL: <b>Sedgwick</b>	FRACTION <b>SE 1/4 SE 1/4 NE 1/4</b>	SECTION NUMBER <b>25</b>	TOWNSHIP NUMBER <b>T 28 S</b>	RANGE NUMBER <b>R 1W E/W</b>
---	---	-----------------------------	----------------------------------	---------------------------------

Distance and direction from nearest town or city street address of well if located within city?  
**6161 S. Meridian Wichita, Kansas**

<b>2</b> WATER WELL OWNER: RR#,ST. ADDRESS,BOX #: CITY, STATE:	<b>BRIDGE PORT MISSIONARY BAPTIST CHURCH</b> <b>6161 S. Meridian</b> <b>Wichita, Kansas</b>	Board of Agriculture, Division of Water Resource Application Number: ZIP CODE: <b>67217</b>
--	---	---

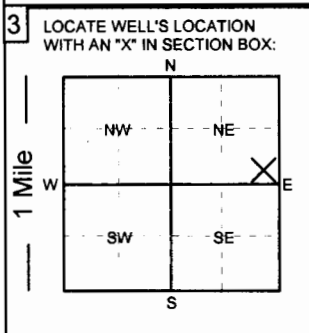

**4** DEPTH OF COMPLETED WELL: **50** ft. ELEVATION:

Depth of groundwater Encountered: \_\_\_\_\_ ft.

WELL'S STATIC WATER LEVEL: **20** FT. BELOW LAND SURFACE MEASURED ON mo/day/yr: **7/17/19**

Pump test data: Well water was \_\_\_\_\_ ft. after \_\_\_\_\_ hours of pumping @ \_\_\_\_\_ gpm  
 Est. Yield: \_\_\_\_\_ gpm Well water was \_\_\_\_\_ ft. after \_\_\_\_\_ hours of pumping @ \_\_\_\_\_ gpm  
 Bore Hole Diameter **12** in. to **50** ft. and \_\_\_\_\_ in. to \_\_\_\_\_ ft.

WELL WATER TO BE USED AS:

<input checked="" type="checkbox"/> 1. Domestic	<input type="checkbox"/> 3. Feedlot	<input type="checkbox"/> 5. Public water supply	<input type="checkbox"/> 7. Lawn and garden only	<input type="checkbox"/> 9. Dewatering	<input type="checkbox"/> 11. Injection well
<input type="checkbox"/> 2. Irrigation	<input type="checkbox"/> 4. Industrial	<input type="checkbox"/> 6. Oil field water supply	<input type="checkbox"/> 8. Air conditioning	<input type="checkbox"/> 10. Monitoring well	<input type="checkbox"/> 12. Other (Specify below)

Was a chemical/bacteriological sample submitted to Department? **YES**  **NO** ; If yes, what mo/day/yr was sample submitted \_\_\_\_\_

Was Water Well Disinfected?  **YES**  **NO**

**5** TYPE OF CASING USED:

<input checked="" type="checkbox"/> 1. Steel	<input type="checkbox"/> 3. RPM (SR)	<input type="checkbox"/> 5. Wrought Iron	<input type="checkbox"/> 7. Fiberglass	<input type="checkbox"/> 9. Other (Specify below)
<input checked="" type="checkbox"/> 2. PVC	<input type="checkbox"/> 4. ABS	<input type="checkbox"/> 6. Asbestos-Cement	<input type="checkbox"/> 8. Concrete tile	

Casing diameter **5** in. to **35** ft., Dia. \_\_\_\_\_ in. to \_\_\_\_\_ ft., Dia. \_\_\_\_\_ in. to \_\_\_\_\_ ft.

Casing height above land surface: **12** in., Weight: **2.35** lbs. / ft. Wall thickness or gauge No. **.214**

TYPE OF SCREEN OR PERFORATION MATERIAL:

<input type="checkbox"/> 1. Steel	<input type="checkbox"/> 3. Stainless Steel	<input type="checkbox"/> 5. Fiberglass	<input checked="" type="checkbox"/> 7. PVC	<input type="checkbox"/> 9. ABS	<input type="checkbox"/> 11. Other (specify)
<input type="checkbox"/> 2. Brass	<input type="checkbox"/> 4. Galvanized	<input type="checkbox"/> 6. Concrete Tile	<input type="checkbox"/> 8. RMP (SR)	<input type="checkbox"/> 10. Asbestos-Cement	<input type="checkbox"/> 12. None used (open hole)

SCREEN OR PERFORATION OPENINGS ARE:

<input type="checkbox"/> 1. Continuous slot	<input type="checkbox"/> 3. Mill slot	<input type="checkbox"/> 5. Gauzed wrapped	<input type="checkbox"/> 7. Torch cut	<input type="checkbox"/> 9. Drilled holes	<input type="checkbox"/> 11. None (open hole)
<input type="checkbox"/> 2. Louvered shutter	<input type="checkbox"/> 4. Key punched	<input type="checkbox"/> 6. Wire wrapped	<input checked="" type="checkbox"/> 8. Saw cut	<input type="checkbox"/> 10. Other (specify)	

SCREEN - PERFORATION INTERVAL From **35** ft. to **50** ft., From \_\_\_\_\_ ft. to \_\_\_\_\_ ft., From \_\_\_\_\_ ft. to \_\_\_\_\_ ft.

GRAVEL PACK INTERVALS: From **24** ft. to **50** ft., From \_\_\_\_\_ ft. to \_\_\_\_\_ ft., From \_\_\_\_\_ ft. to \_\_\_\_\_ ft.

**6** GROUT MATERIALS:  1. Neat cement  2. Cement Grout  3. Bentonite Other **bentonite hole plug**

Grout Intervals: From \_\_\_\_\_ ft. to \_\_\_\_\_ ft., From \_\_\_\_\_ ft. to \_\_\_\_\_ ft., From **4** ft. to **24** ft.

What is the nearest source of possible contamination:

<input type="checkbox"/> 1. Septic tank	<input checked="" type="checkbox"/> 4. Lateral lines	<input type="checkbox"/> 7. Pit privy	<input type="checkbox"/> 10. Livestock pens	<input type="checkbox"/> 13. Insecticide storage	<input type="checkbox"/> 15. Oil well/Gas well
<input type="checkbox"/> 2. Sewer lines	<input type="checkbox"/> 5. Cess Pool	<input type="checkbox"/> 8. Sewage lagoon	<input type="checkbox"/> 11. Fuel storage	<input type="checkbox"/> 14. Abandon water well	<input type="checkbox"/> 16. Other (specify below)
<input type="checkbox"/> 3. Watertight sewer line	<input type="checkbox"/> 6. Seepage pit	<input type="checkbox"/> 9. Feed yard	<input type="checkbox"/> 12. Fertilizer storage		

Direction from well? **Southeast** How many feet? **50 ft. plus**

From	To	LITHOLOGIC LOG	From	To	LITHOLOGIC LOG
0	3	topsoil			
3	35	clay			
35	50	medium sand			
	50	grey shale			

**7** Contractor's or Landowner's Certification: This water well was  1. constructed  2. reconstructed or  3. plugged under my jurisdiction and was completed on (mo/day/year) **7/17/19** and this record is true to the best of my knowledge and belief.

Kansas Water Well Contractor's License No. **236** This water well record was completed on (mo/day/year) **7/19/19**  
 under the business name of **Harp Well and Pump Service** by (signature) **Todd S. Harp**