

WATER WELL PLUGGING RECORD Form WWC-5P


KSA 82a-1212 ID NO.

1 LOCATION OF WATER WELL: Fraction
County: Sedgwick ne 1/4 se 1/4 ne 1/4 sw 1/4
Street/Rural Address of Well Location; if unknown, distance & direction from nearest town or intersection: If at owner's address, check here ☒ 6401 W 36th St S Wichita KS 67215

Section Number 10 Township Number T 28 S Range Number 1 ☐ E ☒ W
Global Positioning Systems (GPS) information:
Latitude: (in decimal degrees)
Longitude: (in decimal degrees)
Elevation:
Horizontal Datum: ☐ WGS84 ☐ NAD83 ☐ NAD27
Collection Method:
☐ GPS unit (Make/Model)
☐ Digital Map/Plots ☐ Topographic Map ☐ Land Survey
Est. Accuracy: ☐ < 2 m ☐ 2-5 m ☐ 5-15 m ☐ > 15 m

2 WATER WELL OWNER: David Poland
RR#, St. Address, Box #: 6401 W 36th St S
City, State ZIP Code: Wichita KS 67215

3 MARK WELL'S LOCATION WITH AN "X" IN SECTION BOX:

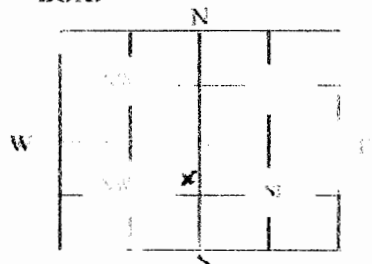

4 DEPTH OF WELL 70 ft.

WELL'S STATIC WATER LEVEL 25 ft

WELL WAS USED AS

☐ Domestic ☒ Public Water Supply ☐ Dewatering
☐ Irrigation ☐ Oil Field Water Supply ☐ Monitoring
☐ Feedlot ☒ Domestic (Lawn & Garden) ☐ Injection Well
☐ Industrial ☐ Air Conditioning ☐ Other

Was a chemical/bacteriological sample submitted to Department? Yes ☐ No ☒

5 TYPE OF BLANK CASING USED:

☐ Steel ☐ RMP (SR) ☐ Wrought ☐ Fiberglass ☐ Other (Specify below)
☒ PVC ☐ ABS ☐ Asbestos-Cement ☐ Concrete Tile

Blank casing diameter 6 in. Was casing pulled? Yes ☐ No ☒ If yes, how much
Casing height above or below land surface 0 m.

6 GROUT PLUG MATERIAL: ☐ Neat cement ☒ Cement grout ☒ Bentonite ☐ Other

Grout Plug Intervals: From 27 ft. to 23 ft., From 2 ft. to 0 ft., From ft. to ft.

What is the nearest source of possible contamination:

☐ Septic tank ☐ Seepage pit ☐ Fuel storage ☒ Other (specify below)
☐ Sewer lines ☐ Pit privy ☐ Fertilizer storage ☒ Well was abandoned
☐ Watertight sewer lines ☐ Sewage lagoon ☐ Insecticide storage
☐ Lateral lines ☐ Feedyard ☐ Abandoned water well Direction from well?
☐ Cess pool ☐ Livestock pens ☐ Oil well/Gas well How many feet?

FROM	TO	PLUGGING MATERIALS	FROM	TO	PLUGGING MATERIALS
2	0	Cement			
23	2	Subsoil/sand			
27	23	Bentonite			
70	27	Sand			

7 CONTRACTOR'S OR LANDOWNER'S CERTIFICATION: This water well was plugged under my jurisdiction and was completed on (mo/day/year) and this record is true to the best of my knowledge and belief. Kansas Water Well Contractor's License No. This Water Well Record was completed on (mo/day/year) under the business name of by (signature) 8-22-19

Send one white copy to Kansas Department of Health & Environment, Geology Section, 1000 SW Jackson Street, Ste. 420, Topeka, KS 66612-1367. Send one copy to WATER WELL OWNER and retain one for your records.
Visit us at <http://www.dhs.kansas.gov/waterwell/index.html> Telephone 785-296-5524.