

WATER WELL PLUGGING RECORD Form WWC-5P

KSA 82a-1212

ID NO.

MW-6

1 LOCATION OF WATER WELL: Fraction NW ¼ NW¼ NW¼ NW ¼ Section Number 1 Township Number T 28 S Range Number 1 ☐ E ☒ W
County: Sedgwick

Street/Rural Address of Well Location; if unknown, distance & direction from nearest town or intersection: If at owner's address, check here ☐ 3919 W. Pawnee St.
Wichita, Kansas 67213

Global Positioning Systems (GPS) information:

Latitude: 37.650374° (in decimal degrees)

Longitude: -97.388946° (in decimal degrees)

Elevation: 1,293.62 feet (top of casing)

Horizontal Datum: ☒ WGS84, ☐ NAD83, ☐ NAD27


Collection Method:

2 WATER WELL OWNER: Town & Country Markets
RR#, St. Address, Box #: P.O. Box 17087
City, State ZIP Code: Wichita, KS 67217

☒ GPS unit (Make/Model: Garmin / GPSmap 64 csx)
☐ Digital Map/Photo, ☐ Topographic Map, ☒ Land Survey

Est. Accuracy: ☒ < 3 m, ☐ 3-5 m, ☐ 5-15 m, ☐ > 15 m

3 MARK WELL'S LOCATION WITH AN "X" IN SECTION BOX:

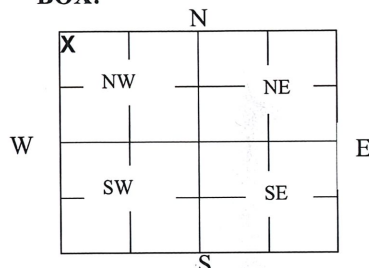

4 DEPTH OF WELL 16.3 ft. (below top of casing)

WELL'S STATIC WATER LEVEL 13.11 ft (below top of casing)

WELL WAS USED AS:

☐ Domestic ☐ Public Water Supply ☐ Dewatering
☐ Irrigation ☐ Oil Field Water Supply ☒ Monitoring
☐ Feedlot ☐ Domestic (Lawn & Garden) ☐ Injection Well
☐ Industrial ☐ Air Conditioning ☐ Other

Was a chemical/bacteriological sample submitted to Department? Yes ☐ No ☒

5 TYPE OF BLANK CASING USED:

☐ Steel ☐ RMP (SR) ☐ Wrought ☐ Fiberglass ☐ Other (Specify below)
☒ PVC ☐ ABS ☐ Asbestos-Cement ☐ Concrete Tile

Blank casing diameter 2 in. Was casing pulled? Yes ☐ No ☒ If yes, how much See note at bottom of page*
Casing height above or below land surface -3 in.

6 GROUT PLUG MATERIAL:

☐ Neat cement ☐ Cement grout ☒ Bentonite ☐ Other

Grout Plug Intervals: From 3 ft. to 16.3 ft., From ft. to ft., From ft. to ft.

What is the nearest source of possible contamination:

☐ Septic tank ☐ Seepage pit ☒ Fuel storage ☐ Other (specify below)
☐ Sewer lines ☐ Pit privy ☐ Fertilizer storage
☐ Watertight sewer lines ☐ Sewage lagoon ☐ Insecticide storage
☐ Lateral lines ☐ Feedyard ☐ Abandoned water well
☐ Cess pool ☐ Livestock pens ☐ Oil well/Gas well

Direction from well? North-northeast
How many feet? 135

FROM	TO	PLUGGING MATERIALS	FROM	TO	PLUGGING MATERIALS
3	16.3	Bentonite chips (hydrated)			

7 CONTRACTOR'S OR LANDOWNER'S CERTIFICATION: This water well was plugged under my jurisdiction and was completed on (mo/day/year) 10/11/2023 and this record is true to the best of my knowledge and belief. Kansas Water Well Contractor's License No. 416. This Water Well Record was completed on (mo/day/year) 10/17/2023 under the business name of Terracon Consultants, Inc. by (signature) Michael W. Montgomery

Send one white copy to Kansas Department of Health & Environment, Geology Section, 1000 SW Jackson Street, Ste. 420, Topeka, KS 66612-1367. Send one copy to WATER WELL OWNER and retain one for your records.

Visit us at <http://www.kdheks.gov/waterwell/index.html> Telephone 785-296-5524.

KSA82a-1212

Revised 1/20/2015

*The well casing was cut at approximately 36 inches below top using and inside pipe-cutter. The pre-cut casing, manhole, and concrete pad are to be removed by others during planned road construction. Surface restoration is to be completed by others during planned construction.