

WATER WELL RECORD Form WWC-5 KSA 82a-1212


LOCATION OF WATER WELL:	Fraction	Section Number	Township Number	Range Number
County: Sedgwick	<i>SE</i> 1/4 <i>SE</i> 1/4 <i>SE</i> 1/4	<i>2</i>	T <i>28</i> S	R <i>1</i> W

Distance and direction from nearest town or city street address of well if located within city?
4100 West 31st St. South Wichita

WATER WELL OWNER:	Wildcat Construction Co.	Well No. 4
RR#, St. Address, Box # :	4421 W. Harry St.	Board of Agriculture, Division of Water Resources
City, State, ZIP Code :	Wichita, Ks. 67209	Application Number:

LOCATE WELL'S LOCATION WITH AN "X" IN SECTION BOX: 4 DEPTH OF COMPLETED WELL... 45' 0" ft. ELEVATION: 1000 ft.

Depth(s) Groundwater Encountered 1 1 ft. 2 ft. 3 ft.

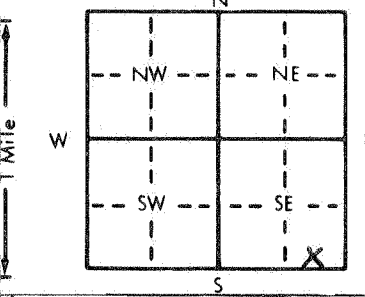

Depth(s) Groundwater Encountered ft. 1 ft. 2 ft. 3 ft.

WELL'S STATIC WATER LEVEL ft. below land surface measured on mo/day/yr 6/21/85

Pump test data: Well water was ft. after hours pumping gpm
Est. Yield 1000 gpm; Well water was ft. after hours pumping gpm
Bore Hole Diameter... 30 in. to 45 ft., and..... in. to ft.

WELL WATER TO BE USED AS:

1 Domestic	3 Feedlot	6 Oil field water supply	9 <u>Dewatering</u>	11 Injection well
2 Irrigation	4 Industrial	7 Lawn and garden only	10 Observation well	12 Other (Specify below)

Was a chemical/bacteriological sample submitted to Department? Yes.....No X.....; If yes, mo/day/yr sample was submitted

Water Well Disinfected? Yes X No

TYPE OF BLANK CASING USED:		5 Wrought iron	8 Concrete tile	CASING JOINTS: Glued	Clamped
1 Steel	3 RMP (SR)	6 Asbestos-Cement	9 Other (specify below)	Welded	X
2 PVC	4 ABS	7 Fiberglass		Threaded	

Blank casing diameter . . . 16 . . . in. to . . . 13 . . . ft., Dia . . . in. to . . . ft., Dia . . . in. to . . . ft.
Casing height above land surface . . . 24 . . . in., weight . . . 36.19 . . . lbs./ft. Wall thickness or gauge No. 1219

TYPE OF SCREEN OR PERFORATION MATERIAL:			7 PVC	10 Asbestos-cement
<u>1 Steel</u>	3 Stainless steel	5 Fiberglass	8 RMP (SR)	11 Other (specify)
<u>2 Brass</u>	4 Galvanized steel	6 Concrete tile	9 ABS	12 None used (open hole)

SCREEN OR PERFORATION OPENINGS ARE:

1 Continuous slot	3 Mill slot	5 Gauzed wrapped	8 Saw cut	11 None (open hole)
2 <u>Louvered shutter</u>	4 Key punched	6 Wire wrapped	9 Drilled holes	
		7 Torch cut	10 Other (specify)	

SCREEN-PERFORATED INTERVALS: From 13 ft. to 43 ft., From ft. to ft.
From ft. to ft., From ft. to ft.
GRAVEL BACK INTERVALS: From 10 ft. to 45 ft., From ft. to ft.

GRAVEL PACK INTERVALS.	From	ft. to	ft., From	ft. to	ft.
	From	ft. to	ft., From	ft. to	ft.

GROUT MATERIAL: 1 Neat cement 2 Cement grout 3 Bentonite 4 Other _____
Grout Intervals: From 0 ft. to 10 ft., From _____ ft. to _____ ft., From _____ ft. to _____ ft.

What is the nearest source of possible contamination:

1 Septic tank	4 Lateral lines	7 Pit privy	10 Livestock pens	14 Abandoned water well
<u>2 Sewer lines</u>	5 Cess pool	8 Sewage lagoon	11 Fuel storage	15 Oil well/Gas well
3 Watertight sewer lines	6 Seepage pit	9 Feedyard	12 Fertilizer storage	16 Other (specify below)
			13 Insecticide storage	

Direction from well? South How many feet? 60

[illegible]

7 CONTRACTOR'S OR LANDOWNER'S CERTIFICATION: This water well was (1) constructed, (2) reconstructed, or (3) plugged under my jurisdiction and was completed on (mo/day/year) 6/21/85 and this record is true to the best of my knowledge and belief. Kansas Water Well Contractor's License No. 102 This Water Well Record was completed on (mo/day/yr) 6/26/85 under the business name of Layne-Western Co. (Wichita) by (signature) [Signature]

INSTRUCTIONS: Use typewriter or ball point pen, **PLEASE PRESS FIRMLY** and **PRINT** clearly. Please fill in blanks, underline or circle the correct answers. Send top three copies to Kansas Department of Health and Environment, Division of Environment, Environmental Geology Section, Topeka, KS 66620. Send one to WATER WELL OWNER and retain one for your records.