


1 LOCATION OF WATER WELL: Fraction SE 1/4 SE 1/4 NE 1/4 Section Number 2 Township Number T 28 S Range Number R 1 W
 County: Sedgwick
 Distance and direction from nearest town or city street address of well if located within city?
No Pac RR & West St Wichita

2 WATER WELL OWNER: Wildcat Construction Co. Well No. 13
 RR#, St. Address, Box #: 4421 W. Harry St. Board of Agriculture, Division of Water Resources
 City, State, ZIP Code: Wichita, Ks. 67209 Application Number:

3 LOCATE WELL'S LOCATION WITH AN "X" IN SECTION BOX:

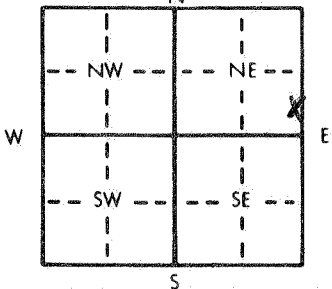

4 DEPTH OF COMPLETED WELL: 44 ft. ELEVATION: ft.
 Depth(s) Groundwater Encountered 1. 11 ft. 2. ft. 3. ft.
 WELL'S STATIC WATER LEVEL 11 ft. below land surface measured on mo/day/yr 7/15/85
 Pump test data: Well water was ft. after hours pumping gpm
 Est. Yield 1000 gpm: Well water was ft. after hours pumping gpm
 Bore Hole Diameter: 30 in. to 44 ft., and in. to ft.
 WELL WATER TO BE USED AS: 5 Public water supply 8 Air conditioning 11 Injection well
 1 Domestic 3 Feedlot 6 Oil field water supply 9 Dewatering 12 Other (Specify below)
 2 Irrigation 4 Industrial 7 Lawn and garden only 10 Observation well
 Was a chemical/bacteriological sample submitted to Department? Yes.....No X.....; If yes, mo/day/yr sample was submitted
 Water Well Disinfected? Yes X No

5 TYPE OF BLANK CASING USED: 5 Wrought iron 8 Concrete tile CASING JOINTS: Glued Clamped
 1 Steel 3 RMP (SR) 6 Asbestos-Cement 9 Other (specify below) Welded X
 2 PVC 4 ABS 7 Fiberglass Threaded.....
 Blank casing diameter 16 in. to 12 ft., Dia 16 in. to 36-44 ft., Dia in. to ft.
 Casing height above land surface 24 in., weight 36.19 lbs./ft. Wall thickness or gauge No. 1219

TYPE OF SCREEN OR PERFORATION MATERIAL: 7 PVC 10 Asbestos-cement
 1 Steel 3 Stainless steel 5 Fiberglass 8 RMP (SR) 11 Other (specify)
 2 Brass 4 Galvanized steel 6 Concrete tile 9 ABS 12 None used (open hole)

SCREEN OR PERFORATION OPENINGS ARE: 5 Gauzed wrapped 8 Saw cut 11 None (open hole)
 1 Continuous slot 3 Mill slot 6 Wire wrapped 9 Drilled holes
 2 Louvered shutter 4 Key punched 7 Torch cut 10 Other (specify)

SCREEN-PERFORATED INTERVALS: From 12 ft. to 36 ft., From ft. to ft.
 From ft. to ft., From ft. to ft.
 GRAVEL PACK INTERVALS: From 10 ft. to 44 ft., From ft. to ft.
 From ft. to ft., From ft. to ft.

6 GROUT MATERIAL: 1 Neat cement 2 Cement grout 3 Bentonite 4 Other
 Grout Intervals: From 0 ft. to 10 ft., From ft. to ft., From ft. to ft.
 What is the nearest source of possible contamination: 10 Livestock pens 14 Abandoned water well
 1 Septic tank 4 Lateral lines 7 Pit privy 11 Fuel storage 15 Oil well/Gas well
 2 Sewer lines 5 Cess pool 8 Sewage lagoon 12 Fertilizer storage 16 Other (specify below)
 3 Watertight sewer lines 6 Seepage pit 9 Feedyard 13 Insecticide storage
 Direction from well? East How many feet? 150

FROM	TO	LITHOLOGIC LOG	FROM	TO	LITHOLOGIC LOG
0	2	Top soil			
2	4	Black clay			
4	6	Brown clay			
6	10	Fine yellow sand			
10	15	Med. sand w/clay layers			
15	22	Med. sand & gravel			
22	27	Gray clay			
27	32	Med. sand & gravel			
32	35	Med. sand w/clay layers			
35	45	Med. sand & gravel			

7 CONTRACTOR'S OR LANDOWNER'S CERTIFICATION: This water well was (1) constructed, (2) reconstructed, or (3) plugged under my jurisdiction and was completed on (mo/day/year) 7/15/85 and this record is true to the best of my knowledge and belief. Kansas
 Water Well Contractor's License No. 102 This Water Well Record was completed on (mo/day/yr) 7/26/85
 under the business name of Layne-Western Co. (Wichita) by (signature) [Signature]
 INSTRUCTIONS: Use typewriter or ball point pen, PLEASE PRESS FIRMLY and PRINT clearly. Please fill in blanks, underline or circle the correct answers. Send top three copies to Kansas Department of Health and Environment, Division of Environment, Environmental Geology Section, Topeka, KS 66620. Send one to WATER WELL OWNER and retain one for your records.