

1 LOCATION OF WATER WELL: Fraction NE 1/4 SE 1/4 SE 1/4 Section Number 2 Township Number T 28 S Range Number R 1 E
 County: SEDGWICK
 Distance and direction from nearest town or city street address of well if located within city?

3003 S. WEST - WICHITA

2 WATER WELL OWNER: UNITED PARCEL SERVICE


RR#, St. Address, Box # : 223 N. JAMES

Board of Agriculture, Division of Water Resources

City, State, ZIP Code : KANSAS CITY, KS 66118

Application Number:

3 LOCATE WELL'S LOCATION WITH AN "X" IN SECTION BOX:

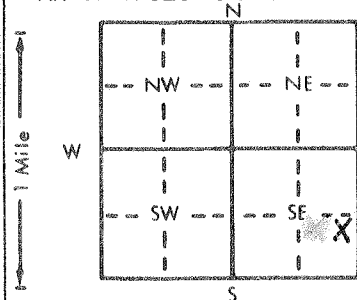

4 DEPTH OF COMPLETED WELL: 15 ft. ELEVATION:

Depth(s) Groundwater Encountered 1. 11 ft. 2. 11 ft. 3. 11 ft.

WELL'S STATIC WATER LEVEL 10.75 ft. below land surface measured on mo/day/yr 4-25-94

Pump test data: Well water was 8 ft. after 11 hours pumping 15 gpm

Est. Yield 15 gpm: Well water was 8 ft. after 11 hours pumping 15 gpm

Bore Hole Diameter 8 in. to 8 ft. and 8 in. to 8 ft.

WELL WATER TO BE USED AS: 5 Public water supply 8 Air conditioning 11 Injection well

1 Domestic 3 Feedlot 6 Oil field water supply 9 Dewatering 12 Other (Specify below)

2 Irrigation 4 Industrial 7 Lawn and garden only 10 Monitoring well

Was a chemical/bacteriological sample submitted to Department? Yes No X; If yes, mo/day/yr sample was submitted

Water Well Disinfected? Yes No X

5 TYPE OF BLANK CASING USED:

5 Wrought iron

8 Concrete tile

CASING JOINTS: Glued Clamped

1 Steel

3 RMP (SR)

6 Asbestos-Cement

9 Other (specify below)

Welded

2 PVC

4 ABS

7 Fiberglass

Threaded


Casing height above land surface FLUSH in., weight 103 lbs./ft. Wall thickness or gauge No. 154

TYPE OF SCREEN OR PERFORATION MATERIAL:

1 Steel

3 Stainless steel

5 Fiberglass

7 PVC

10 Asbestos-cement

2 Brass

4 Galvanized steel

6 Concrete tile

8 RMP (SR)

11 Other (specify)




9 ABS

12 None used (open hole)

SCREEN OR PERFORATION OPENINGS ARE:

1 Continuous slot

3 Mill slot

5 Gauzed wrapped

8 Saw cut

11 None (open hole)

2 Louvered shutter

4 Key punched

6 Wire wrapped

9 Drilled holes



7 Torch cut

10 Other (specify)




6 GROUT MATERIAL:

1 Neat cement

2 Cement grout

3 Bentonite

4 Other


What is the nearest source of possible contamination:

1 Septic tank

4 Lateral lines

7 Pit privy

10 Livestock pens

14 Abandoned water well

2 Sewer lines

5 Cess pool

8 Sewage lagoon

11 Fuel storage

15 Oil well/Gas well

3 Watertight sewer lines

6 Seepage pit

9 Feedyard

12 Fertilizer storage

16 Other (specify below)

13 Insecticide storage

Direction from well? NW

How many feet? 100

FROM	TO	LITHOLOGIC LOG	FROM	TO	PLUGGING INTERVALS
<u>0</u>	<u>2.0</u>	<u>FILL</u>			
<u>2.0</u>	<u>5.0</u>	<u>SILT, SAND</u>			
<u>5.0</u>	<u>11.0</u>	<u>SAND</u>			
<u>11.0</u>	<u>15.0</u>	<u>SAND, SILT</u>			

NOTE: ALLISON IRWIN CONTACTED DON TAYLOR ABOUT FORMS BEING TURNED IN LATE ON 4-27-94 @ 9:00 A.M.

7 CONTRACTOR'S OR LANDOWNER'S CERTIFICATION: This water well was (1) constructed (2) reconstructed, or (3) plugged under my jurisdiction and was completed on (mo/day/year) 4-22-94 and this record is true to the best of my knowledge and belief. Kansas

Water Well Contractor's License No. 531 This Water Well Record was completed on (mo/day/yr) 7-11-94

under the business name of GSI

by (signature) Mike Simpson