USE TYPEWRITER OR BALL POINT PEN-PRESS FIRMLY, PRINT CLEARLY.

WATER WELL RECORD
KSA 82a-1201-1215

Kansas Department of Health and Environment-Division of Environment
(Water well Contractors)
Topeka, Kansas 66620

1. Location of well:	County	Fraction	Section number	Township number	Range number
	SEDGWICK	1/4 SE 1/4 SW 1/4	7	T 28 S	R 1W E/W

2. Distance and direction from nearest town or city: Jerry Arnold
Street address of well location if in city: 102 Susie Schulte, Kansas

3. Owner of well: Walt Stauffer Construction
R.R. or street: 3535 W. 13th St.
City, stote, zip code: Wichita, Kansas

4. Locote with "X" in section below:

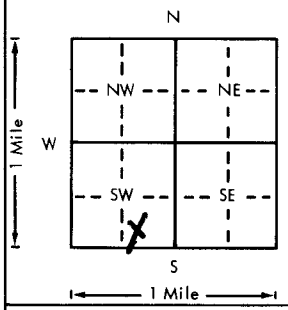

Sketch map:

6. Bore hole dia. 11 in. Completion dote
Well depth 120 ft. 6-6-78

7. __ Cable tool X Rotary __ Driven __ Dug
__ Hollow rod __ Jetted __ Bored __ Reverse rotary

8. Use: X Domestic __ Public supply __ Industry
__ Irrigotion __ Air conditioning __ Stock
__ Lawn __ Oil field water __ Other

9. Cosing: Materiol styrene Height: Above or below ///
Threaded __ Welded gl Surface 12 in.
RMP X PVC __ Weight __ lbs./ft.
Dia. 5 in. to 120 ft. depth Wall Thickness: inches or
Dia. __ in. to __ ft. depth gage No. .200

5. Type and color of moteriol	From	To
Topsoil	0	2
Clay	2	21
Fine Sand	21	33
Clay	33	102
Fine Sand	102	120

(Use a second sheet if needed)

10. Screen: Monufacturer's name Sunflower Plastic
Type styrene Dia. 5"
Slot/size .06 Length 10'
Set between 110 ft. and 120 ft.
ft. and ft.
Gravel pack? yes Size range of material 1/4-1/8"

11. Static water level: mo./day/yr.
30 ft. below land surface Dote 6-6-78

12. Pumping level below land surfaces:
ft. after hrs. pumping g.p.m.
ft. after hrs. pumping g.p.m.
Estimated maximum yield g.p.m.

13. Water sample submitted: mo./doy/yr.
__ Yes __ No Date

14. Well head completion:
X Pitless adapter 12 Inches above grade

15. Well grouted? yes 1-2Fine Sand Mix
With: __ Neat cement __ Bentonite X Concrete
Depth: From 40" ft. to 14 ft.

16. Nearest source of possible contamination: septic
ft. 60 Direction S.E. Type tank
Well disinfected upon completion? X Yes __ No

17. Pump: __ Not installed
Manufacturer's name Sta-Rite
Model number 20P4D02 HP 3/4 Volts 230
Length of drop pipe 100 ft. capacity 20 g.p.m.
Type:
X Submersible __ Turbine
__ Jet __ Reciprocating
__ Centrifugal __ Other

18. Elevation:

Topography:
__ Hill
__ Slope
__ Upland
__ Valley

19. Remarks: Flat Ground

20. Water well contractor's certification:
This well was drilled under my jurisdiction and this report is true to the best of my knowledge and belief.
Harp Well & Pump 236
Business name License No.
Address Wichita, Kansas 67209
Signed M. Arnold Date 7-1-78
Authorized representative

T 28 R 1W E Sec 7 1/4 1/4 1/4 SESW

Forward the white, blue and pink copies to the Department of Health and Environment

Form WWC-5

MT-1023