WATER WELL RECORD Form WWC-5 KSA 82a-1212

1 LOCATION OF WATER WELL: County: Sedgwick | Fraction: NE ¼ SE ¼ SW ¼ | Section Number: 7 | Township Number: T 28 (S) | Range Number: R 1 (E/W)

Distance and direction from nearest town or city street address of well if located within city? 11129 W. Peter - Wichita by Schulte Ks.

2 WATER WELL OWNER: Randy Pauly

RR#, St. Address, Box # : R.R. #1

City, State, ZIP Code : Mt. Hope, Ks. 67108

Board of Agriculture, Division of Water Resources Application Number:

3 LOCATE WELL'S LOCATION WITH AN "X" IN SECTION BOX:

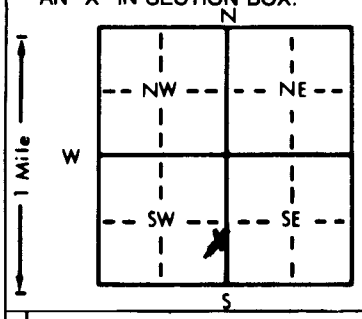

4 DEPTH OF COMPLETED WELL: 42 ft. ELEVATION:

Depth(s) Groundwater Encountered 1. 26 ft. 2. ft. 3. ft.

WELL'S STATIC WATER LEVEL 26 ft. below land surface measured on mo/day/yr 6-5-87

Pump test data: Well water was 26 ft. after 42 hours pumping 20 gpm

Est. Yield 50 gpm: Well water was ft. after hours pumping gpm

Bore Hole Diameter 11 in. to 42 ft., and in. to ft.

WELL WATER TO BE USED AS: (1) Domestic (2) Irrigation (3) Feedlot (4) Industrial (5) Public water supply (6) Oil field water supply (7) Lawn and garden only (8) Air conditioning (9) Dewatering (10) Observation well (11) Injection well (12) Other (Specify below)

Was a chemical/bacteriological sample submitted to Department? Yes No; If yes, mo/day/yr sample was submitted

Water Well Disinfected? Yes X No

5 TYPE OF BLANK CASING USED: (1) Steel (2) PVC (3) RMP (SR) (4) ABS (5) Wrought iron (6) Asbestos-Cement (7) Fiberglass (8) Concrete tile (9) Other (specify below)

CASING JOINTS: Glued X Clamped Welded Threaded

Blank casing diameter 5 in. to 30 ft., Dia in. to ft., Dia in. to ft.

Casing height above land surface 12 in., weight 1.59 lbs./ft. Wall thickness or gauge No. SDR-26

TYPE OF SCREEN OR PERFORATION MATERIAL: (1) Steel (2) Brass (3) Stainless steel (4) Galvanized steel (5) Fiberglass (6) Concrete tile (7) PVC (8) RMP (SR) (9) ABS (10) Asbestos-cement (11) Other (specify) (12) None used (open hole)

SCREEN OR PERFORATION OPENINGS ARE: (1) Continuous slot (2) Louvered shutter (3) Mill slot (4) Key punched (5) Gauzed wrapped (6) Wire wrapped (7) Torch cut (8) Saw cut (9) Drilled holes (10) Other (specify) (11) None (open hole)

SCREEN-PERFORATED INTERVALS: From 30 ft. to 42 ft., From ft. to ft.; From ft. to ft., From ft. to ft.

GRAVEL PACK INTERVALS: From 23 ft. to 42 ft., From ft. to ft.; From ft. to ft., From ft. to ft.

6 GROUT MATERIAL: (1) Neat cement (2) Cement grout (3) Bentonite (4) Other

Grout Intervals: From 3 ft. to 23 ft., From ft. to ft., From ft. to ft.

What is the nearest source of possible contamination: (1) Septic tank (2) Sewer lines (3) Watertight sewer lines (4) Lateral lines (5) Cess pool (6) Seepage pit (7) Pit privy (8) Sewage lagoon (9) Feedyard (10) Livestock pens (11) Fuel storage (12) Fertilizer storage (13) Insecticide storage (14) Abandoned water well (15) Oil well/Gas well (16) Other (specify below)

Direction from well? S.E. How many feet? 60 ft.

FROM	TO	LITHOLOGIC LOG	FROM	TO	LITHOLOGIC LOG
0	2	Top Soil			
2	18	Clay			
18	42	Med. Sand			

7 CONTRACTOR'S OR LANDOWNER'S CERTIFICATION: This water well was (1) constructed, (2) reconstructed, or (3) plugged under my jurisdiction and was completed on (mo/day/year) 6-5-87 and this record is true to the best of my knowledge and belief. Kansas Water Well Contractor's License No. 318 This Water Well Record was completed on (mo/day/yr) 6-5-87 under the business name of Weidner Drilling by (signature) [signature]

INSTRUCTIONS: Use typewriter or ball point pen. *PLEASE PRESS FIRMLY* and *PRINT* clearly. Please fill in blanks, underline or circle the correct answers. Send top three copies to Kansas Department of Health and Environment, Office of Oil Field and Environmental Geology, Regulation and Permitting Section, Topeka, Kansas 66620-7500, Telephone: 913-862-9360. Send one to WATER WELL OWNER and retain one for your records.