WATER WELL RECORD Form WWC-5 KSA 82a-1212

1 LOCATION OF WATER WELL: County: Sedgwick	Fraction: NE ¼ NW ¼ SE ¼	Section Number: 7	Township Number: T 28 S	Range Number: R 1 (W)

Distance and direction from nearest town or city street address of well if located within city?
2622.8'N & 1519.9'W of SE corner of Sec. 7

2 WATER WELL OWNER: Kansas Dept. of Health and Environment SCHULTE MW14
RR#, St. Address, Box # : Forbes Field, Bldg. 740 Board of Agriculture, Division of Water Resources
City, State, ZIP Code : Topeka KS 66620 Application Number:

3 LOCATE WELL'S LOCATION WITH AN "X" IN SECTION BOX:

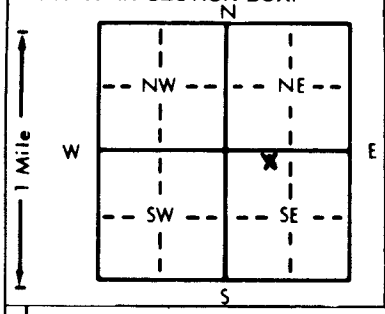

4 DEPTH OF COMPLETED WELL 48.5 ft. ELEVATION: 1336.83 MSL TOC
Depth(s) Groundwater Encountered 1. 28.21 ft. 2. TOC ft. 3. 1335.33 GS ft.
WELL'S STATIC WATER LEVEL 1308.62 ft. ~~below land surface~~ measured on mo/day/yr 091492
Pump test data: Well water was ft. after hours pumping gpm
Est. Yield gpm: Well water was ft. after hours pumping gpm
Bore Hole Diameter 11 in. to 1285.3 ft., and in. to ft.
WELL WATER TO BE USED AS: 5 Public water supply 8 Air conditioning 11 Injection well
1 Domestic 3 Feedlot 6 Oil field water supply 9 Dewatering 12 Other (Specify below)
2 Irrigation 4 Industrial 7 Lawn and garden only (10) Monitoring well MW14
Was a (chemical/)bacteriological sample submitted to Department? (Yes) No; If yes, mo/day/yr sample was submitted Part of RFP 82095 Water Well Disinfected? Yes (No)

5 TYPE OF BLANK CASING USED: 5 Wrought iron 8 Concrete tile CASING JOINTS: Glued Clamped
1 Steel 3 RMP (SR) 6 Asbestos-Cement 9 Other (specify below) Welded
(2) PVC 4 ABS 7 Fiberglass (Threaded)
Blank casing diameter 5.563 O.D. in. to 1306.8 ft., Dia in. to ft., Dia in. to ft.
Casing height above land surface 1.50 ft. in., weight 2.77 lbs./ft. Wall thickness or gauge No. Sch. 40
TYPE OF SCREEN OR PERFORATION MATERIAL: (7) PVC 5.04 I.D. 10 Asbestos-cement
1 Steel 3 Stainless steel 5 Fiberglass 8 RMP (SR) 11 Other (specify)
2 Brass 4 Galvanized steel 6 Concrete tile 9 ABS 12 None used (open hole)
SCREEN OR PERFORATION OPENINGS ARE: 5 Gauzed wrapped 8 Saw cut 11 None (open hole)
1 Continuous slot (3) Mill slot .010 6 Wire wrapped 9 Drilled holes
2 Louvered shutter 4 Key punched 7 Torch cut 10 Other (specify)
SCREEN-PERFORATED INTERVALS: From 1306.8 ft. to 1286.8 ft., From ft. to ft.
Flush bottom plug From ft. to ft., From ft. to ft.
GRAVEL PACK INTERVALS: From 1312.2 ft. to 1285.3 ft., From ft. to ft.
8 x 16 + natural From ft. to ft., From ft. to ft.

6 GROUT MATERIAL: 1 Neat cement 2 Cement grout (3) Bentonite (4) Other bentonite pellets
Grout Intervals: From 1335.3 ft. to 1315.3 ft., From 1315.3 ft. to 1312.2 ft., From ft. to ft.
What is the nearest source of possible contamination: 10 Livestock pens 14 Abandoned water well
1 Septic tank 4 Lateral lines 7 Pit privy 11 Fuel storage (15) Oil well/Gas well
2 Sewer lines 5 Cess pool 8 Sewage lagoon 12 Fertilizer storage 16 Other (specify below)
3 Watertight sewer lines 6 Seepage pit 9 Feedyard 13 Insecticide storage
Direction from well? West How many feet? 1000

FROM	TO	LITHOLOGIC LOG	FROM	TO	PLUGGING INTERVALS
1335.3	1332.3	topsoil, br. clay			E Log 091692
1332.3	1320.3	sandy reddish br. clay			Sampled 091792
1320.3	1317.8	sandy tannish br. clay			concrete pad + Steel
1317.8	1304.8	sand, VF-M			protective cover
1304.8	1290.3	sand, F-C, with some gravel			
1290.3	1285.3	clay, red with sand, stiff-compact			

7 CONTRACTOR'S OR LANDOWNER'S CERTIFICATION: This water well was (1) constructed (2) reconstructed, or (3) plugged under my jurisdiction and was completed on (mo/day/year) 090392 and 091892 and this record is true to the best of my knowledge and belief. Kansas Water Well Contractor's License No. 483 This Water Well Record was completed on (mo/day/yr) 020393 under the business name of Total Environmental Services/Technologies by (signature) Dwight Binkley

INSTRUCTIONS: Use typewriter or ball point pen. *PLEASE PRESS FIRMLY* and *PRINT* clearly. Please fill in blanks, underline or circle the correct answers. Send top three copies to Kansas Department of Health and Environment, Bureau of Water, Topeka, Kansas 66620-0001. Telephone: 913-296-5545. Send one to WATER WELL OWNER and retain one for your records.

OFFICE USE ONLY I II E/W SEC. ¼ ¼ ¼