USE TYPEWRITER OR BALL POINT PEN-PRESS FIRMLY, PRINT CLEARLY.

WATER WELL RECORD
KSA 82a-1201-1215

Kansas Department of Health and Environment-Division of Environment
(Water well Contractors)
Topeka, Kansas 66620

1. Location of well:	County	Fraction	Section number	Township number	Range number
	Sedgwick	NW 1/4 SW 1/4 SW 1/4	8	T 28 S	R 1 ~~E~~W

2. Distance and direction from nearest town or city: 1/2 Mi. E. of Schulte, Ks.
Street address of well location if in city:

3. Owner of well: Mid Continent Indust. Park
R.R. or street: P. O. Box 12086
City, state, zip code: Wichita, Kansas 67277

4. Locate with "X" in section below:

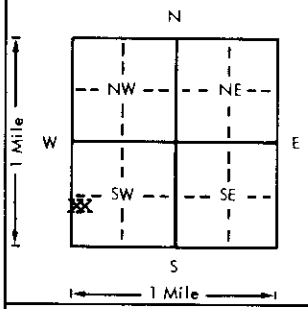

Sketch map: Well D-2

6. Bore hole dia. 30 in. Completion date 12/11/79
Well depth 99 ft.

7. __ Cable tool __ Rotary __ Driven __ Dug
__ Hollow rod __ Jetted __ Bored X Reverse rotary

8. Use: __ Domestic __ Public supply __ Industry
__ Irrigation __ Air conditioning __ Stock
__ Lawn __ Oil field water X Other

9. Casing: Material PVC
Threaded ___ Welded ___
RMP ___ PVC X
Dia. 16 in. to 39 ft. depth
Dia. ___ in. to ___ ft. depth
Height: Above or below Surface 12 in.
Weight 19 lbs./ft.
Wall Thickness: inches or gage No. .6"

10. Screen: Manufacturer's name Jet Stream
Type PVC Dia. 16"
Slot/gauze .125 Length 60'
Set between 99 ft. and 39 ft.
___ ft. and ___ ft.
Gravel pack? X Size range of material 1/8 x 1/4"

11. Static water level: 21 ft. below land surface Date 12/10/79 mo./day/yr.

12. Pumping level below land surfaces:
___ ft. after ___ hrs. pumping ___ g.p.m.
___ ft. after ___ hrs. pumping ___ g.p.m.
Estimated maximum yield ___ g.p.m.

13. Water sample submitted: mo./day/yr.
__ Yes X No Date ___

14. Well head completion:
__ Pitless adapter 12 Inches above grade

15. Well grouted? yes
With: ___ Neat cement ___ Bentonite X Concrete
Depth: From 0 ft. to 20 ft.

16. Nearest source of possible contamination:
ft. 1600 Direction SE Type Sewer
Well disinfected upon completion? X Yes ___ No

17. Pump: X Not installed
Manufacturer's name ___
Model number ___ HP ___ Volts ___
Length of drop pipe ___ ft. capacity ___ g.p.m.
Type:
__ Submersible __ Turbine
__ Jet __ Reciprocating
__ Centrifugal __ Other

5. Type and color of material

Type and color of material	From	To
Top soil	0	5
Sandy red clay	5	15
Med. sand & gravel	15	20
Fine sand	20	25
Med. sand & gravel	25	40
Gray clay	40	60
Blue clay	60	80
Sandy clay	80	87
Med. sand & gravel	87	95
Sand & gravel & some clay	95	100

(Use a second sheet if needed)

18. Elevation:

Topography:
__ Hill
__ Slope
X Upland
__ Valley

19. Remarks: Disposal Well for Heat Pump Water

20. Water well contractor's certification:
This well was drilled under my jurisdiction and this report is true to the best of my knowledge and belief.
Layne Western Co. 102
Business name License No.
Address Wichita, Kansas
Signed [signature] Date 12-18-79
Authorized representative

28 T 1 R 8 W Sec NW SW SW 1/4 1/4 1/4

Forward the white, blue and pink copies to the Department of Health and Environment

Form WWC-5

MI-1023