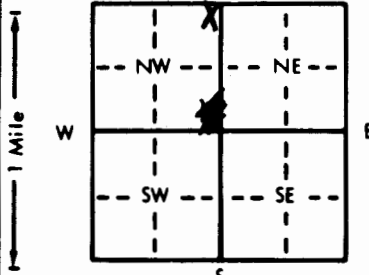


1 LOCATION OF WATER WELL: County: SEDGWICK		Fraction NE ¼ NE ¼ NW ¼		Section Number 10	Township Number T 28 S	Range Number R 1 W EW
Distance and direction from nearest town or city street address of well if located within city? 42' South & 400' West of NE Corner, NW ¼ Wichita, KS.						
2 WATER WELL OWNER: RR#, St. Address, Box # : City, State, ZIP Code :		ECCO Development Corporation 610 North Main Wichita, Kansas 67203 Board of Agriculture, Division of Water Resources Application Number:				
3 LOCATE WELL'S LOCATION WITH AN "X" IN SECTION BOX:		4 DEPTH OF COMPLETED WELL: 53 ft. ELEVATION:				
		Depth(s) Groundwater Encountered 1. ft. 2. ft. 3. ft.				
		WELL'S STATIC WATER LEVEL 24.2 ft. below land surface measured on mo/day/yr 10-21-87				
		Pump test data: Well water was ft. after hours pumping gpm				
		Est. Yield gpm: Well water was ft. after hours pumping gpm				
Bore Hole Diameter 4 1/2 to ft. and in. to ft.		WELL WATER TO BE USED AS:				
1 Domestic		3 Feedlot		6 Oil field water supply		8 Air conditioning
2 Irrigation		4 Industrial		7 Lawn and garden only		10 Observation well
11 Injection well		12 Other (Specify below)				
Was a chemical/bacteriological sample submitted to Department? Yes.....No..... XX ; If yes, mo/day/yr sample was submitted						
Water Well Disinfected? Yes No XX						
5 TYPE OF BLANK CASING USED:						
1 Steel 3 RMP (SR) 5 Wrought iron 8 Concrete tile CASING JOINTS: Glued Clamped						
2 PVC 160 4 ABS 6 Asbestos-Cement 9 Other (specify below) Welded metal screws						
7 Fiberglass Threaded.....						
Blank casing diameter 2 in. to 47 ft., Dia in. to ft., Dia in. to ft.						
Casing height above land surface 24 in., weight 43 lbs./ft. Wall thickness or gauge No.091						
TYPE OF SCREEN OR PERFORATION MATERIAL:						
1 Steel 3 Stainless steel 5 Fiberglass 8 RMP (SR) 10 Asbestos-cement						
2 Brass 4 Galvanized steel 6 Concrete tile 9 ABS 11 Other (specify)						
12 None used (open hole)						
SCREEN OR PERFORATION OPENINGS ARE:						
1 Continuous slot 5 Gauzed wrapped 8 Saw cut 11 None (open hole)						
2 Louvered shutter 3 Mill slot 6 Wire wrapped 9 Drilled holes						
4 Key punched 7 Torch cut 10 Other (specify)						
SCREEN-PERFORATED INTERVALS: From 47 ft. to 53 ft., From ft. to ft.						
From ft. to ft., From ft. to ft.						
GRAVEL PACK INTERVALS: From 30 ft. to 47 ft., From ft. to ft.						
From ft. to ft., From ft. to ft.						
6 GROUT MATERIAL: 1 Neat cement 2 Cement grout 3 Bentonite 4 Other Hole Plug						
Grout Intervals: From 0 ft. to 30 ft., From 53 ft. to 75 ft., From ft. to ft.						
What is the nearest source of possible contamination:						
1 Septic tank 4 Lateral lines 7 Pit privy 10 Livestock pens 14 Abandoned water well						
2 Sewer lines 5 Cess pool 8 Sewage lagoon 11 Fuel storage 15 Oil well/Gas well						
3 Watertight sewer lines 6 Seepage pit 9 Feedyard 12 Fertilizer storage 16 Other (specify below)						
None apparent						
VOC's from Cessna's Plant						
Direction from well? How many feet?						
FROM	TO	LITHOLOGIC LOG	FROM	TO	LITHOLOGIC LOG	
0	1	Topsoil	50	53	Fine to Coarse Sand	
1	8	Brown Clay			Fine to Coarse Gravel (H ₂ O)	
8	12	Tan Clay	53	64	Gray & Yellow Clay	
12	14	Fine to Coarse Sand	64	70	Very Fine to Fine Sand	
		Fine to Medium Gravel			Mixed with Clay	
14	15 1/2	Tan clay	70	75	Gray Clay	
15 1/2	20	Fine to Coarse Sand				
		Fine to Medium Gravel				
20	22	Yellow Clay				
22	29 1/2	Fine to Coarse Sand				
		Fine to Coarse Gravel (H ₂ O)				
29 1/2	30	Yellow Clay				
30	49 1/2	Fine to Coarse Sand				
		Fine to Coarse Gravel (H ₂ O)				
49 1/2	50	Tan Clay				
7 CONTRACTOR'S OR LANDOWNER'S CERTIFICATION: This water well was (1) constructed, (2) reconstructed, or (3) plugged under my jurisdiction and was completed on (mo/day/year) 10-21-87 and this record is true to the best of my knowledge and belief. Kansas Water Well Contractor's License No. 236 This Water Well Record was completed on (mo/day/yr) 12-1-87 under the business name of Harp Well & Pump Service, Inc. by (signature) <i>Mary Arnold</i>						
INSTRUCTIONS: Use typewriter or ball point pen. PLEASE PRESS FIRMLY and PRINT clearly. Please fill in blanks, underline or circle the correct answers. Send top three copies to Kansas Department of Health and Environment, Office of Oil Field and Environmental Geology, Regulation and Permitting Section, Topeka, Kansas 66620-7500, Telephone: 913-862-9360. Send one to WATER WELL OWNER and retain one for your records.						