USE TYPEWRITER OR BALL POINT PEN-PRESS FIRMLY, PRINT CLEARLY.

WATER WELL RECORD
KSA 82a-1201-1215

Kansas Department of Health and Environment-Division of Environment
(Water well Contractors)
Topeka, Konsas 66620

1. Location of well:	County	Fraction	Section number	Township number	Range number
	Sedgwick	SE NW NW SW 1/4 1/4 1/4	10	T 28 S	R 1W E/W

2. Distance and direction from nearest town or city:
Street address of well location if in city: 7100 West 35th, Wichita, Kansas

3. Owner of well: Dave Rush
R.R. or street: 7100 West 35th
City, state, zip code: Wichita, Kansas

4. Locate with "X" in section below: Sketch map:

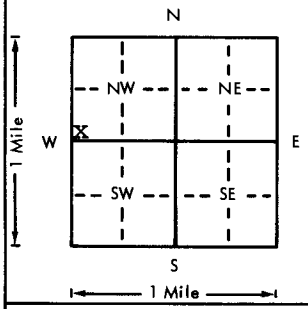

6. Bore hole dia. 11 in. Completion date
Well depth 60 ft. 7-26-77

7. __ Cable tool X Rotary __ Driven __ Dug
__ Hollow rad __ Jetted __ Bored __ Reverse rotary

8. Use: X Domestic __ Public supply __ Industry
__ Irrigation __ Air conditioning __ Stock
__ Lawn __ Oil field water __ Other

9. Casing: Material Styrene Height: Above or below
Threaded __ Welded gl Surface 12 in.
RMP X PVC ___ Weight ___ lbs./ft.
Dia. 5 in. to 60 ft. depth Wall Thickness: inches or
Dia. ___ in. to ___ ft. depth gage No. .200

5. Type and color of material	From	To
Topsoil	0	3
Clay	3	20
Fine Sand	20	38
Clay	38	43
Medium Sand	43	60
(Use a second sheet if needed)		

10. Screen: Manufacturer's name Sunflower Plastic
Type Styrene Dia. 5"
Slot/gauze .06 Length 15'
Set between 45 ft. and 60 ft.
___ ft. and ___ ft.
Gravel pack? yes Size range of material 1/4-1/8"

11. Static water level: mo./day/yr.
25 ft. below land surface Date 7-26-77

12. Pumping level below land surfaces:
___ ft. after ___ hrs. pumping ___ g.p.m.
___ ft. after ___ hrs. pumping ___ g.p.m.
Estimated maximum yield ___ g.p.m.

13. Water sample submitted: mo./day/yr.
___ Yes ___ No Date

14. Well head completion: Capped
___ Pitless adapter 12 Inches above grade

15. Well grouted? yes 1to2 fine sand mix.
With: ___ Neat cement ___ Bentonite X Concrete
Depth: From 40" ft. to 14 ft.

16. Nearest source of possible contamination: Septic
ft. 100 Direction East Type Tank
Well disinfected upon completion? X Yes ___ No

17. Pump: X Not installed
Manufacturer's name
Model number HP Volts
Length of drop pipe ft. capacity g.p.m.
Type:
___ Submersible ___ Turbine
___ Jet ___ Reciprocating
___ Centrifugal ___ Other

18. Elevation:
Topography:
___ Hill
___ Slope
X Upland
___ Valley

19. Remarks:

20. Water well contractor's certification:
This well was drilled under my jurisdiction and this report is true to the best of my knowledge and belief.
Harp Well & Pump 236
Business name License No.
Address Wichita, Kansas
Signed M. Arnold Date 8-31-77
Authorized representative

28 T 1 W R 10 Sec SW 1/4 1/4 1/4

Forward the white, blue and pink copies to the Department of Health and Environment

Form WWC-5

MI-1023