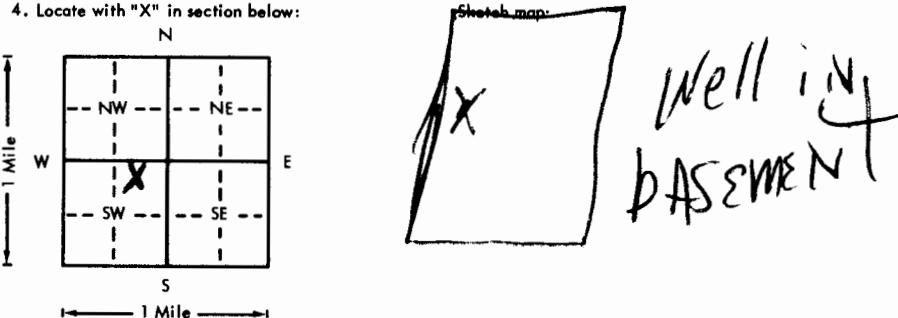


USE TYPEWRITER OR BALL
POINT PEN-PRESS FIRMLY,
PRINT CLEARLY.

WATER WELL RECORD
KSA 82a-1201-1215

Kansas Department of Health and
Environment-Division of Environment
(Water well Contractors)
Topeka, Kansas 66620

1. Location of well:		County: <u>Sedgwick</u>	Fraction: <u>NW 1/4 NE 1/4 SW 1/4</u>	Section number: <u>10</u>	Township number: <u>T 28 S</u>	Range number: <u>R 1 E</u>
2. Distance and direction from nearest town or city: Street address of well location if in city: <u>3650 Faulkner Wichita KS</u>				3. Owner of well: <u>Robert Keys</u> R.R. or street: <u>3100 So 145 East</u> City, state, zip code: <u>Wichita KS 67230</u>		
4. Locate with "X" in section below: 				6. Bore hole dia. <u>10</u> in. Completion date: <u>8/7/76</u> Well depth <u>50</u> ft.		
5. Type and color of material				7. ☒ Cable tool ☒ Rotary ☐ Driven ☐ Dug ☐ Hollow rod ☐ Jetted ☐ Bored ☐ Reverse rotary		
				8. Use: ☒ Domestic ☐ Public supply ☐ Industry ☐ Irrigation ☐ Air conditioning ☐ Stock ☐ Lawn ☐ Oil field water ☐ Other		
TOP SOIL Red clay fine sugar sand green clay course gravel				9. Casing: Material <u>PC</u> Height: Above or below Threaded ☐ Welded ☒ Surface <u>13</u> in. RMP <u>5</u> PVC <u>5</u> Weight <u>231</u> lbs./ft. Dia. <u>5</u> in. to <u>50</u> ft. depth Wall Thickness: inches or Dia. <u>5</u> in. to <u>50</u> ft. depth gage No. <u>160</u>		
				10. Screen: Manufacturer's name <u>Pumpco</u> Type <u>PVC</u> Dia. <u>5</u> in. Not gauze <u>1116</u> Length <u>57</u> Set between <u>45</u> ft. and <u>50</u> ft. Gravel pack? <u>yes</u> Size range of material <u>3/8</u>		
				11. Static water level: <u>28</u> ft. below land surface Date <u>8/7/76</u>		
				12. Pumping level below land surfaces: <u>29</u> ft. after <u>1</u> hrs. pumping <u>20</u> g.p.m. <u> </u> ft. after <u> </u> hrs. pumping <u> </u> g.p.m. Estimated maximum yield <u>80</u> g.p.m.		
				13. Water sample submitted: <u> </u> mo./day/yr. ☐ Yes ☒ No Date <u> </u>		
				14. Well head completion: <u> </u> Pitless adapter <u>18</u> inches above grade		
				15. Well grouted? <u>yes</u> With: ☒ Neat cement ☐ Bentonite ☐ Concrete Depth: From <u>10</u> ft. to <u>23</u> ft.		
				16. Nearest source of possible contamination: ft. <u> </u> Direction <u> </u> Type <u> </u> Well disinfected upon completion? ☒ Yes ☐ No		
				17. Pump: ☒ Not installed Manufacturer's name <u> </u> Model number <u> </u> HP <u> </u> Volts <u> </u> Length of drop pipe <u> </u> ft. capacity <u> </u> g.p.m. Type: ☐ Submersible ☐ Turbine ☐ Jet ☐ Reciprocating ☐ Centrifugal ☐ Other		
				20. Water well contractor's certification: This well was drilled under my jurisdiction and this report is true to the best of my knowledge and belief. <u>Weninger Drilling</u> Business name <u>Colwich</u> Address <u>813 B</u> Signed <u> </u> Date <u>8/7/76</u> Authorized representative		
18. Elevation:		19. Remarks:				
Topography: ☐ Hill ☒ Slope ☒ Upland ☐ Valley						

Forward the white, blue and pink copies to the Department of Health and Environment