

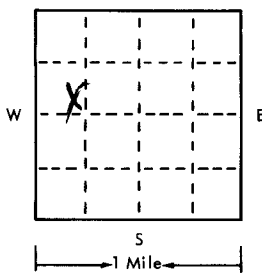
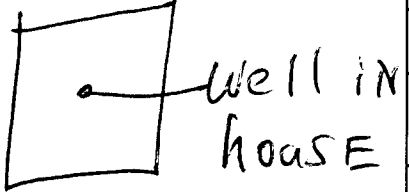
USE TYPEWRITER OR BALL
POINT PEN-PRESS FIRMLY,
PRINT CLEARLY.

WATER WELL RECORD
KSA 82a-1201-1215

T R EW sec 1/4 1/4 1/4 No.

Kansas State Dept. Of Health
(Water Well Contractors)
Forbes-Bldg. 740
Topeka, Kansas 66620

NW SW NE SW

1 Location of well:	County: <u>Sedg.</u>	Township name: <u>WACO.</u>	Fraction: <u>SE NW 1/4</u>	Section number: <u>10</u>	Town number: <u>28S</u>	Range number: <u>1W</u>
Distance and direction from nearest town or city: Street address of well location if in city: <u>3725 Fairlawn Wichita</u>				3 Owner of well: <u>Robt Keyes</u> Address: <u>3100 So 145 E Wichita KS</u>		
Locate with "X" in section below: 				Sketch map: 		
2				4 Well depth: <u>50</u> ft. Date of completion <u>12/8</u> Well diameter <u>5</u> in.		
Type and color of material				5 ☐ Cable tool ☒ Rotary ☐ Driven ☐ Dug ☐ Hollow rod ☐ Jetted ☐ Bored ☐ Reverse rotary		
From To				6 Use: ☒ Domestic ☐ Public supply ☐ Industry ☐ Irrigation ☐ Air conditioning ☐ Commercial ☐ Test well		
Top Soil				7 Casing: Material <u>EMP</u> Height: above/below Threading ☐ Welded ☒ Surface <u>12</u> in. Diam. <u>5</u> in. Weight <u>150</u> lbs./ft. <u>100</u> <u>5</u> in. to <u>50</u> ft. depth Drive shoe? ☐ Yes ☒ No		
Clay				8 Screen: <u>Sunflower</u> Type <u>Plastic</u> Dia. <u>5</u> in. Slot/gauze <u>1/8</u> Length <u>10 ft.</u> Set between <u>10</u> ft. and <u>50</u> ft.		
fine SAND				Fittings: <u>3/8</u> Gravel pack ☒ Yes ☐ No Size range of material <u>3/8</u>		
CLAY				9 Static water level: <u>28</u> ft. below land surface Date <u>12/8</u>		
fine SAND to GRAVE				10 Pumping level below land surfaces: ____ ft. after ____ hrs. pumping ____ g.p.m. ____ ft. after ____ hrs. pumping ____ g.p.m. Estimated maximum yield <u>80</u> g.p.m.		
				11 Water sample submitted: ☐ Yes ☒ No Date ____		
				12 Well head completion: ☐ Pitless adapter <u>12</u> inches above grade		
				13 Well grouted? ☒ Yes ☐ No ☒ Neat cement ☐ Bentonite ☐ Depth: From <u>0</u> ft. to <u>10 ft. grade</u>		
				14 Nearest source of possible contamination: ft. ____ Direction <u>NONE</u> Type ____ Well disinfected upon completion? ☒ Yes ☐ No		
				15 Pump: ☒ Not installed Manufacturer's name ____ Model number ____ HP ____ Volts ____ Length of drop pipe ____ ft. capacity ____ g.p.m. Type: ☐ Submersible ☐ Turbine ☐ Jet ☐ Reciprocating ☐ Centrifugal ☐ Other		
16 Remarks: elevation				17 Water well contractor's certification: This well was drilled under my jurisdiction and this report is true to the best of my knowledge and belief. <u>Weninger Del.</u> <u>3/8</u> Business name <u>E I Copewich</u> License No. <u>KS</u> Address <u>1010 E 10th St</u> Date <u>12/8</u> Signature <u>[Signature]</u> Authorized representative		
Topography: ☐ Hill ☐ Slope ☒ Upland ☐ Valley						

Forward the white, blue and pink copies to the Kansas State Dept. Of Health.

Form WWC-5