

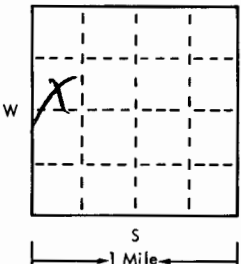
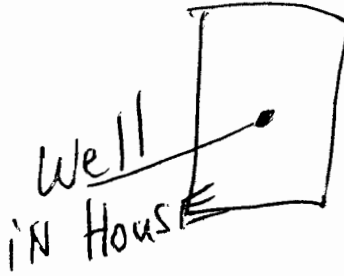
USE TYPEWRITER OR BALL
POINT PEN-PRESS FIRMLY,
PRINT CLEARLY.

WATER WELL RECORD
KSA 82a-1201-1215

NE SW NE SW

T R EW sec 1/4 1/4 1/4 No.

Kansas State Dept. Of Health
(Water Well Contractors)
Forbes-Bldg. 740
Topeka, Kansas 66620

1 Location of well:	County <u>Sedg.</u>	Township name <u>WACO.</u>	Fraction <u>8E NW 1/4</u>	Section number <u>10</u>	Town number <u>28S</u>	Range number <u>1W</u>
Distance and direction from nearest town or city:				3 Owner of well: <u>GARY JO HANNING</u>		
Street address of well location if in city: <u>6635 Hollywood Wichita, KS.</u>				Address: <u>1204 W. 29th St. Wichita, KS.</u>		
Locate with "X" in section below:		Sketch map:		4 Well depth: <u>60</u> ft. Date of completion <u>8/10</u> Well diameter <u>5</u> in.		
				5 ☐ Cable tool ☒ Rotary ☐ Driven ☐ Dug ☐ Hollow rod ☐ Jetted ☐ Bored ☐ Reverse rotary		
2 Type and color of material				6 Use: ☒ Domestic ☐ Public supply ☐ Industry ☐ Irrigation ☐ Air conditioning ☐ Commercial ☐ Test well ☐		
				7 Casing: Material <u>PMP</u> Height: above/below Threaded ☐ Welded ☒ Surface <u>130</u> in. Diam. <u>5</u> in. to <u>60</u> ft. depth Drive shoe? ☐ Yes ☐ No		
				8 Screen: <u>Sunflower</u> Type <u>PLASTIC</u> Dia. <u>5</u> Slot/gauze <u>1/8</u> Length <u>10</u> Set between <u>50</u> ft. and <u>60</u> ft. Fittings: <u>3/8</u> Gravel pack ☒ Yes ☐ No Size range of material <u>3/8</u>		
				9 Static water level: <u>30</u> ft. below land surface Date <u>8/10</u>		
				10 Pumping level below land surface: <u>4</u> hrs. after <u>4</u> hrs. pumping <u>80</u> g.p.m. <u>33</u> ft. after <u>4</u> hrs. pumping <u>80</u> g.p.m. Estimated maximum yield <u>80</u> g.p.m.		
Top Soil. 0 10 CLAY 10 18 fine sand 18 29 CLAY 29 33 fine sand 33 45 GRAVEL 45 60				11 Water sample submitted: ☐ Yes ☒ No Date _____		
				12 Well head completion: ☐ Pitless adapter <u>12</u> inches above grade		
				13 Well grouted? ☒ Yes ☐ No ☒ Neat cement ☐ Bentonite ☐ Depth: From <u>0</u> ft. to <u>10</u> ft. <u>fe grade</u>		
				14 Nearest source of possible contamination: ft. _____ Direction <u>None</u> Type _____ Well disinfected upon completion? ☒ Yes ☐ No		
				15 Pump: ☒ Not installed Manufacturer's name _____ Model number _____ HP _____ Volts _____ Length of drop pipe _____ ft. capacity _____ g.m.p. Type: ☐ Submersible ☐ Turbine ☐ Jet ☐ Reciprocating ☐ Centrifugal ☐ Other		
16 Remarks: elevation Topography: ☐ Hill ☐ Slope ☒ Upland ☐ Valley				17 Water well contractor's certification: This well was drilled under my jurisdiction and this report is true to the best of my knowledge and belief. <u>Weninger Dr. Co.</u> License No. <u>318</u> Address <u>21 Colwich St.</u> Signature <u>[Signature]</u> Date <u>8/10/15</u>		

Forward the white, blue and pink copies to the Kansas State Dept. Of Health.

Form WWC-5