USE TYPEWRITER OR BALL POINT PEN-PRESS FIRMLY, PRINT CLEARLY.

WATER WELL RECORD
KSA 82a-1201-1215

Kansas Department of Health and Environment-Division of Environment
(Water well Contractors)
Topeka, Kansas 66620

1. Location of well:	County	Fraction	Section number	Township number	Range number
	Sedgwick	1/4 SW 1/4 SE 1/4	11	T 28 S	R 1W E/W

2. Distance and direction from nearest town or city:
Street address of well location if in city: 3852 South Young Street Wichita, Kansas

3. Owner of well: Ed Hughes
R.R. or street: 819 Wood Avenue
City, state, zip code: Wichita, Kansas

4. Locate with "X" in section below:

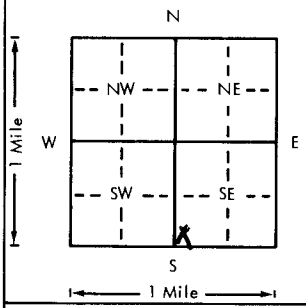

Sketch map:

5. Type and color of material	From	To
Topsoil	0	3
Clay	3	22
Fine sand	22	43
Medium sand	43	55

(Use a second sheet if needed)

6. Bore hole dia. 11 in. Completion date
Well depth 55 ft. 8-7-78

7. __ Cable tool X Rotary __ Driven __ Dug
__ Hollow rod __ Jetted __ Bored __ Reverse rotary

8. Use: X Domestic __ Public supply __ Industry
__ Irrigation __ Air conditioning __ Stock
__ Lawn __ Oil field water __ Other

9. Casing: Material Styrene
Threaded __ Welded gl
RMP X PVC
Dia. 5 in. to 55 ft. depth
Dia. __ in. to __ ft. depth
Height: Above or below
Surface 12 in.
Weight lbs./ft.
Wall Thickness: inches or gage No. .200

10. Screw: Manufacturer's name Sunflower plastic
Type styrene Dia. 5"
Slot/gage .06 Length 10'
Set between 45 ft. and 55 ft.
ft. and ft.
Gravel pack? yes Size range of material ¼-1/8"

11. Static water level: ma./day/yr.
15 ft. below land surface Date 8-7-78

12. Pumping level below land surfaces:
ft. after hrs. pumping g.p.m.
ft. after hrs. pumping g.p.m.
Estimated maximum yield g.p.m.

13. Water sample submitted: mo./day/yr.
__ Yes __ No Date

14. Well head completion: capped
__ Pitless adapter 12 Inches above grade

15. Well grouted? yes 1-2fine sand mix
With: __ Neat cement __ Bentonite X Concrete
Depth: From 0 ft. to 10 ft.

16. Nearest source of possible contamination:
ft. 56 Direction East Type Septic
Well disinfected upon completion? X Yes Tank No

17. Pump: X Not installed
Manufacturer's name
Model number HP Volts
Length of drop pipe ft. capacity g.p.m.
Type:
__ Submersible __ Turbine
__ Jet __ Reciprocating
__ Centrifugal __ Other

18. Elevation:
Topography:
__ Hill
__ Slope
__ Upland
__ Valley

19. Remarks:
Flat Ground

20. Water well contractor's certification:
This well was drilled under my jurisdiction and this report is true to the best of my knowledge and belief.
Business name Harp Well & Pump License No. 236
Address Wichita, Kansas 67209
Signed M. Arnold (Authorized representative) Date 10-3-78

T 28 R 1 E W Sec 11 1/4 1/4 1/4 SWSE

Forward the white, blue and pink copies to the Department of Health and Environment

Form WWC-5

MI-1023