USE TYPEWRITER OR BALL POINT PEN-PRESS FIRMLY, PRINT CLEARLY.

WATER WELL RECORD
KSA 82a-1201-1215

Kansas Department of Health and Environment-Division of Environment
(Water well Contractors)
Topeka, Kansas 66620

1. Location of well:	County	Fraction	Section number	Township number	Range number
	Sedgwick	SW 1/4 NE 1/4 NW 1/4	12	T 28 S	R 1W E (W)

2. Distance and direction from nearest town or city:

Street address of well location if in city: 3321 S. Leonine

3. Owner of well: Mr. D. Cline
R.R. or street: 3321 S. Leonine
City, state, zip code: Wichita K 67217

4. Locate with "X" in section below: Sketch map:

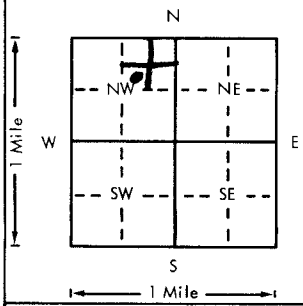

6. Bore hole dia. ___ in. Completion date ___
Well depth 19 ft. 5-19-79

7. __ Cable tool __ Rotary X Driven __ Dug
__ Hollow rod __ Jetted __ Bored __ Reverse rotary

8. Use: __ Domestic __ Public supply __ Industry
__ Irrigation __ Air conditioning __ Stock
X Lawn __ Oil field water __ Other

9. Casing: Material Galv pipe Height: Above or below
Threaded X Welded ___ Surface 12 in.
RMP ___ PVC ___ Weight ✓ lbs./ft.
Dia. 1¼ in. to 0 ft. depth Wall Thickness: inches or
Dia. 1¼ in. to 19 ft. depth gage No. 8

5. Type and color of material	From	To
Dark Gray Clay	0	8
unknown sand point well	8	19

10. Screen: Manufacturer's name Clayton Mark
Type Sand point Dia. 1 1/4
Slot (gauze) 60 Length 4 ft
Set between 15 ft. and 19 ft.
___ ft. and ___ ft.
Grovel pack? No Size range of material ___

11. Static water level: mo./day/yr.
8 ft. below land surface Date 5-19-79

12. Pumping level below land surfaces:
___ ft. after ___ hrs. pumping ___ g.p.m.
___ ft. after ___ hrs. pumping ___ g.p.m.
Estimated maximum yield 20 g.p.m.

13. Water sample submitted: mo./day/yr.
__ Yes X No Date ___

14. Well head completion:
__ Pitless adapter 12 Inches above grade

15. Well grouted? Yes
With: __ Neat cement __ Bentonite x Concrete
Depth: From 0 ft. to 8 ft.

16. Nearest source of possible contamination: Sanitary
ft. 18 Direction North Type Sewer
Well disinfected upon completion? __ Yes X No

17. Pump: __ Not installed
Manufacturer's name F & W
Model number CP1055 HP 1/2 Volts 115
Length of drop pipe 19 ft. capacity 15 g.p.m.
Type:
__ Submersible __ Turbine
X Jet __ Reciprocating
__ Centrifugal __ Other

(Use a second sheet if needed)

18. Elevation:

Topography:
__ Hill
__ Slope
__ Upland
__ Valley

19. Remarks: 1¼" Steel pipe located inside 12 ft. #200 (.20) RMP Casing with Concrete from 0 to 8 ft. (water level) on outside Casing with Sanitary well seal

20. Water well contractor's certification:
This well was drilled under my jurisdiction and this report is true to the best of my knowledge and belief.
Rotheree Pump & Well 295
Business name License No.
Address 827 W. 29 So
Signed [signature] Date 5-21-79
Authorized representative

28 — 1 (W) — 12 — SW NE NW
T R Sec 1/4 1/4 1/4

Forward the white, blue and pink copies to the Department of Health and Environment

Form WWC-5

MI-1023