USE TYPEWRITER OR BALL POINT PEN-PRESS FIRMLY, PRINT CLEARLY.

28 T | 1 R | W EW | 16 sec | SW 1/4 | SW 1/4 | SW 1/4 No.

WATER WELL RECORD
KSA 82a-1201-1215

Kansas State Dept. Of Health
(Water Well Contractors)
Forbes-Bldg. 740
Topeka, Kansas 66620

1 Location of well:	County	Township name	Froction	Section number	Town number	Range number
	Sedgwick		SW4-NE4	16	T 28 S	R 1 W

Distance and direction from nearest town or city: 1/2 Mi. South & 1/2 Mi. W. of intersection of 39th St.
Street address of well location if in city: S. & 71st W., Wichita

3 Owner of well: Vulcan Materials Company
Wichita, Kansas
Well No. 10 (TH 24-72)
Address:

Locate with "X" in section below:

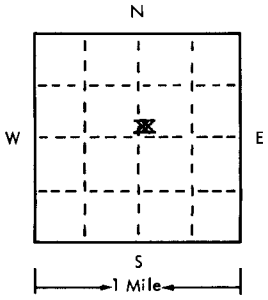

Sketch map:

Well No. 10

4 Well depth: 123 ft. Date of completion 10/10/75
Well diameter 30-48 in.

5 ☐ Cable tool ☐ Rotary ☐ Driven ☐ Dug
☐ Hollow rod ☐ Jetted ☐ Bored ☒ Reverse rotary

6 Use: ☐ Domestic ☐ Public supply ☒ Industry
☐ Irrigation ☐ Air conditioning ☐ Commercial
☐ Test well ☐ _____

7 Casing: Material Stl Height: ~~XXX~~/below
Threaded ☐ Welded ☒ Surface 4 Ft. in.
Diam. Weight 62 lbs./ft.
16 in. to 88 ft. depth Drive shoe? ☐ Yes ☒ No
___ in. to ___ ft. depth

2 Type and color of material	From	To
Top soil	0	2
Brown clay	2	14
Med. to coarse sand & gravel	14	72
Clay	72	90
Med. to coarse sand & gravel w/some clay	90	122
Blue shale	122	125
(use a second sheet if needed)		

8 Screen:
Manufacturer Layne
Type St. Stl. Dia. 16"
Slot/gauze .105" Length 35'
Set between 88 ft. and 123 ft.
Fittings:
Gravel pack ☒ Yes ☐ No Size range of material 1/8-3/8

9 Static water level:
25 ft. below land surface Date 10/6/75

10 Pumping level below land surfaces:
60 ft. after 3 hrs. pumping 1000 g.p.m.
52 ft. after 1 hrs. pumping 750 g.p.m.
Estimated maximum yield 1200 g.p.m.

11 Water sample submitted:
☒ Yes ☐ No Date 10/6/75

12 Well head completion:
☒ Pitless adapter ☐ Inches above grade

13 Well grouted? ☒ Yes ☐ No
☒ Neat cement ☐ Bentonite ☐ _____
Depth: From 0 ft. to 20 ft.

14 Nearest source of possible contamination:
ft. 1000 Direction E. Type Creek
Well disinfected upon completion? ☒ Yes ☐ No

15 Pump: ☐ Not installed
Manufacturer's name Layne
Model number 10 HP 50 Volts 460
Length of drop pipe 60 ft. capacity 500 g.m.p.
Type:
☒ Submersible ☐ Turbine
☐ Jet ☐ Reciprocating
☐ Certrifugal ☐ Other

16 Remarks: elevation 1298.6 MSL

Topography:
☐ Hill
☐ Slope
☐ Upland
☒ Valley Arkansas River

17 Water well contractor's certification:
This well was drilled under my jurisdiction and this report is true to the best of my knowledge and belief.
Layne Western Co. 102
Business name License No.
Address Wichita, Kansas
Signed [signature] Authorized representative Date 10/22/75

Forward the white, blue and pink copies to the Kansas State Dept. Of Health.

Form WWC-5

677-H

28 1W 16 SWSWSW