USE TYPEWRITER OR BALL POINT PEN-PRESS FIRMLY, PRINT CLEARLY.

WATER WELL RECORD
KSA 82a-1201-1215

Kansas Department of Health and Environment-Division of Environment
(Water well Contractors)
Topeka, Kansas 66620

1. Location of well:	County	Fraction	Section number	Township number	Range number
	SEDGWICK	1/4 NE 1/4 NE 1/4	17	T 28 S	R 1W E/W

2. Distonce and direction from nearest town or city: 1000' So. of McArthur Rd. on Tyler Rd. on the
Street address of well location if in city:

3. Owner of well: Grover White
R.R. or street: 402 Lyndon
City, state, zip code: Haysville, Kansas

4. Locate with "X" in section below:

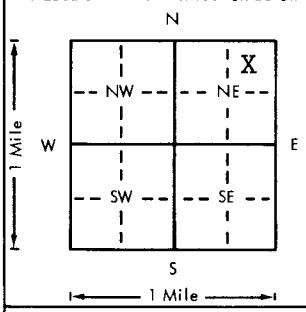

Sketch map:
W. side of the road.
Schulte, Kansas

6. Bore hole dia. 11 in. Completion date
Well depth 85 ft. 4-18-78

7. __ Cable tool X Rotary __ Driven __ Dug
__ Hollow rod __ Jetted __ Bored __ Reverse rotary

8. Use: X Domestic __ Public supply __ Industry
__ Irrigation __ Air conditioning __ Stock
__ Lawn __ Oil field water __ Other

9. Casing: Material styrene Height: Above or below
Threaded __ Welded gl Surface 12 in.
RMP X PVC __ Weight __ lbs./ft.
Dia. 5 in. to 85 ft. depth Wall Thickness: inches or
Dia. __ in. to __ ft. depth gage No. .200

5. Type and color of material	From	To
Topsoil	0	3
Clay	3	24
Fine Sand	24	30
Medium Sand	30	35
Clay	35	38
Fine Sand	38	54
Clay	54	56
Fine Sand	56	85
(Use a second sheet if needed)		

10. Screen: Manufacturer's name Sunflower Plastic
Type styrene Dia. 5"
Slot size .06 Length 20'
Set between 65 ft. and 85 ft.
ft. and ft.
Gravel pack? yes Size ronge of material 1/4-1/8"

11. Static water level: mo./doy/yr.
30 ft. below land surface Date 4-18-78

12. Pumping level below land surfaces:
ft. after hrs. pumping g.p.m.
ft. after hrs. pumping g.p.m.
Estimated maximum yield g.p.m.

13. Water sample submitted: mo./day/yr.
__ Yes __ No Date

14. Well head completion: capped
__ Pitless adapter 12 Inches above grade

15. Well grouted? yes 1-2 Fine Sand Mix
With: __ Neat cement __ Bentonite X Concrete
Depth: From 40" ft. to 14 ft.

16. Nearest source of possible contamination: NONE
ft. Direction Type
Well disinfected upon completion? X Yes __ No

17. Pump: X Not installed
Manufacturer's name
Model number HP Volts
Length of drop pipe ft. capacity g.p.m.
Type:
__ Submersible __ Turbine
__ Jet __ Reciprocating
__ Centrifugal __ Other

18. Elevation:

Topography:
__ Hill
__ Slope
__ Upland
__ Valley

19. Remarks: Flat Ground

Septic Tank not installed at this time.
No apparent source for contamination.

20. Water well contractor's certification:
This well wos drilled under my jurisdiction and this report is true to the best of my knowledge and belief.
Harp Well & Pump 236
Business name License No.
Address Wichita, Kansas
Signed M. Arnold Date 7-1-78
Authorized representative

T 28 R 1 (E) W Sec 17 1/4 1/4 1/4 NE

Forward the white, blue and pink copies to the Department of Health and Environment

Form WWC-5

MI-1023