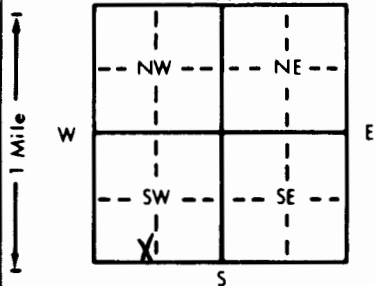


1 LOCATION OF WATER WELL:		Fraction	Section Number	Township Number	Range Number
County: SEDGWICK		SE 1/4 SW 1/4 SW 1/4	21	T 28 S	R 1 W E/W
Distance and direction from nearest town or city street address of well if located within city? 1/2 E. of Tyler Rd., N. side of 55th St. S., Wichita, Ks.					
2 WATER WELL OWNER:		Roman Thome			
RR#, St. Address, Box # :		Clearwater, Ks.			
City, State, ZIP Code :		Board of Agriculture, Division of Water Resources Application Number:			
3 LOCATE WELL'S LOCATION WITH AN "X" IN SECTION BOX:		4 DEPTH OF COMPLETED WELL 80 ft. ELEVATION:			
		Depth(s) Groundwater Encountered 1. 49 ft. 2. ft. 3. ft.			
		WELL'S STATIC WATER LEVEL 49 ft. below land surface measured on mo/day/yr 8-12-82			
		Pump test data: Well water was ft. after hours pumping gpm			
		Est. Yield gpm: Well water was ft. after hours pumping gpm			
Bore Hole Diameter 11 in. to ft., and in. to ft.		WELL WATER TO BE USED AS:			
1 Domestic 3 Feedlot 6 Oil field water supply 9 Dewatering 12 Other (Specify below)		5 Public water supply 8 Air conditioning 11 Injection well			
2 Irrigation 4 Industrial 7 Lawn and garden only 10 Observation well		Was a chemical/bacteriological sample submitted to Department? Yes No X; If yes, mo/day/yr sample was submitted			
5 TYPE OF BLANK CASING USED:		CASING JOINTS: Glued X Clamped			
1 Steel 3 RMP (SR)		5 Wrought iron 8 Concrete tile			
2 PVC 4 ABS		6 Asbestos-Cement 9 Other (specify below)			
Blank casing diameter 5 in. to 50 ft. Dia in. to ft.		Cer-Mac Styrene SDR-26 in. to ft.			
Casing height above land surface 12 in., weight 1.59 lbs./ft. Wall thickness or gauge No. 203		7 Fiberglass 10 Asbestos-cement			
TYPE OF SCREEN OR PERFORATION MATERIAL:		8 RMP (SR) 11 Other (specify)			
1 Steel 3 Stainless steel 5 Fiberglass 8 RMP (SR) 11 Other (specify)		2 Brass 4 Galvanized steel 6 Concrete tile 9 ABS 12 None used (open hole)			
SCREEN OR PERFORATION OPENINGS ARE:		5 Gauzed wrapped 8 Saw cut 11 None (open hole)			
1 Continuous slot 3 Mill slot 6 Wire wrapped 9 Drilled holes		2 Louvered shutter 4 Key punched 7 Torch cut 10 Other (specify)			
SCREEN-PERFORATED INTERVALS:		From 50 ft. to 80 ft. From ft. to ft.			
GRAVEL PACK INTERVALS:		From 10 ft. to 80 ft. From ft. to ft.			
6 GROUT MATERIAL:		2 Cement grout 3 Bentonite 4 Other			
Grout Intervals: From 0 ft. to 10 ft. From ft. to ft. From ft. to ft.		What is the nearest source of possible contamination:			
1 Septic tank 4 Lateral lines 7 Pit privy 10 Livestock pens 14 Abandoned water well		2 Sewer lines 5 Cess pool 8 Sewage lagoon 11 Fuel storage 15 Oil well/Gas well			
3 Watertight sewer lines 6 Seepage pit 9 Feedyard 12 Fertilizer storage 16 Other (specify below)		NONE APPARENT			
Direction from well?		How many feet?			
FROM	TO	LITHOLOGIC LOG	FROM	TO	LITHOLOGIC LOG
0	3	Topsoil			
3	16	Clay			
16	42	Medium Sand			
42	53	Clay			
53	80	Medium Sand and Clay			
7 CONTRACTOR'S OR LANDOWNER'S CERTIFICATION: This water well was (1) constructed, (2) reconstructed, or (3) plugged under my jurisdiction and was completed on (mo/day/year) 8-12-82 and this record is true to the best of my knowledge and belief. Kansas Water Well Contractor's License No. 236 This Water Well Record was completed on (mo/day/yr) 10-18-82 under the business name of Harp Well & Pump Serv., Inc. by (signature) M. Arnold					
INSTRUCTIONS: Use typewriter or ball point pen, PLEASE PRESS FIRMLY and PRINT clearly. Please fill in blanks, underline or circle the correct answers. Send top three copies to Kansas Department of Health and Environment, Division of Environment, Environmental Geology Section, Topeka, KS 66620. Send one to WATER WELL OWNER and retain one for your records.					

OFFICE USE ONLY

T

28

R

END

SEC.

21

SE 1/4

SW 1/4

SW 1/4

SW 1/4