USE TYPEWRITER OR BALL POINT PEN-PRESS FIRMLY, PRINT CLEARLY.

WATER WELL RECORD
KSA 82a-1201-1215

Kansas Department of Health and Environment-Division of Environment
(Water well Contractors)
Topeka, Kansas 66620

1. Location of well:	County	Fraction	Section number	Township number	Range number
	Sedgwick	1/4 NW 1/4 NW 1/4	23	T 28 S	R 1W E/W

2. Distance and direction from nearest town or city:

Street address of well location if in city: 4800 South Hoover Wichita, Kansas

3. Owner of well: James M. Heimerman
R.R. or street: 4800 South Hoover
City, state, zip code: Wichita, Kansas

4. Locate with "X" in section below: Sketch map:

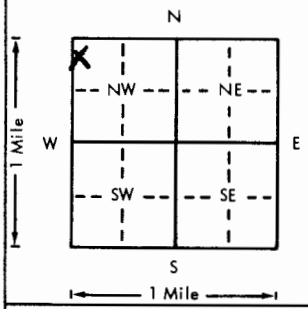

6. Bore hole dia. 11 in. Completion date
Well depth 110 ft. 10-19-77

7. __ Cable tool X Rotary __ Driven __ Dug
__ Hollow rod __ Jetted __ Bored __ Reverse rotary

8. Use: __ Domestic __ Public supply __ Industry
__ Irrigation __ Air conditioning __ Stock
X Lawn __ Oil field water __ Other

9. Casing: Material styrene Height: Above or below
Threaded __ Welded gl Surface 12 in.
RMP X PVC Weight lbs./ft.
Dia. 5 in. to 110 ft. depth Wall Thickness: inches or
Dia. __ in. to __ ft. depth gage No. .200

5. Type and color of material	From	To
Topsoil	0	3
Clay	3	48
Fine Sand	48	70
Clay	70	82
Fine Sand	82	110

(Use a second sheet if needed)

10. Screen: Manufacturer's name Sunflower Plastic
Type styrene Dia. 5"
Slot/gauge .06 Length 40'
Set between 50 ft. and 65 ft.
85 ft. and 110 ft.
Gravel pack? yes Size range of material 1/4-1 1/8"

11. Static water level:
25 ft. below land surface Date 10-19-77 mo./day/yr.

12. Pumping level below land surfaces:
__ ft. after __ hrs. pumping __ g.p.m.
__ ft. after __ hrs. pumping __ g.p.m.
Estimated maximum yield __ g.p.m.

13. Water sample submitted: mo./day/yr.
__ Yes __ No Date

14. Well head completion:
X Pitless adapter 12 Inches above grade

15. Well grouted? yes 1-2 fine sand mix
With: __ Neat cement __ Bentanite X Concrete
Depth: From 40" ft. to 14 ft.

16. Nearest source of possible contamination: Septic
ft. 200 Direction West Type ~~Tank~~
Well disinfected upon completion? X Yes __ No

17. Pump: __ Not installed
Manufacturer's name Sta-Rite
Model number 20P4D02 HP 3/4 Volts 230
Length of drop pipe 50 ft. capacity 20 g.p.m.
Type:
X Submersible __ Turbine
__ Jet __ Reciprocating
__ Centrifugal __ Other

28 T 1 R (W) E 23 Sec NWNW 1/4 1/4 1/4

18. Elevation:
Topography:
__ Hill
__ Slope
__ Upland
__ Valley

19. Remarks:
Flat Ground

20. Water well contractor's certification:
This well was drilled under my jurisdiction and this report is true to the best of my knowledge and belief.
Business name Harp WEll & Pump License No. 236
Address Wichita, Kansas
Signed M. Arnold Authorized representative Date 5-11-78

Forward the white, blue and pink copies to the Department of Health and Environment

Form WWC-5

MI-1023