

1 LOCATION OF WATER WELL: County: SEDGWICK Fraction: SW 1/4 SW 1/4 SE 1/4 Section Number: 23 Township Number: T 28 S Range Number: R 1 E

Distance and direction from nearest town or city street address of well if located within city?

3910 W 55 ST SOUTH, WICHITA, KS 2 MILE N 2 1/2 MILE WEST HAYSVILLE, Kansas

2 WATER WELL OWNER: ERNEST SPONSILL SR.


RR#, St. Address, Box # 3910 W 55 ST SOUTH

City, State, ZIP Code WICHITA, Kansas 67217

Board of Agriculture, Division of Water Resources

Application Number:

3 LOCATE WELL'S LOCATION WITH AN "X" IN SECTION BOX:

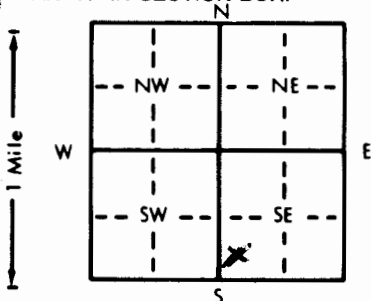

4 DEPTH OF COMPLETED WELL: 48 ft. ELEVATION:

Depth(s) Groundwater Encountered 1. 24 ft. 2. 24 ft. 3. 12-13-82 ft.

WELL'S STATIC WATER LEVEL 24 ft. below land surface measured on mo/day/yr 12-13-82

Pump test data: Well water was 24 ft. after 2 hours pumping 26 gpm

Est. Yield 50 gpm: Well water was 24 ft. after 2 hours pumping 26 gpm

Bore Hole Diameter 9 in. to 48 ft. and 48 in. to 48 ft.

WELL WATER TO BE USED AS: 5 Public water supply 8 Air conditioning 11 Injection well

1 Domestic 3 Feedlot 6 Oil field water supply 9 Dewatering 12 Other (Specify below)

2 Irrigation 4 Industrial 7 Lawn and garden only 10 Observation well

Was a chemical/bacteriological sample submitted to Department? Yes No If yes, mo/day/yr sample was submitted

Water Well Disinfected? Yes No

5 TYPE OF BLANK CASING USED:

1 Steel

3 RMP (SR)

5 Wrought iron

8 Concrete tile

CASING JOINTS: Glued Clamped

2 PVC

4 ABS

6 Asbestos-Cement

9 Other (specify below)

Welded

7 Fiberglass

Threaded

Blank casing diameter 5 in. to 28 ft., Dia. 5 in. to 28 ft., Dia. 5 in. to 28 ft., Dia.

Casing height above land surface 5 in., weight 28 lbs./ft. Wall thickness or gauge No. 5

TYPE OF SCREEN OR PERFORATION MATERIAL:

1 Steel

3 Stainless steel

5 Fiberglass

7 PVC

10 Asbestos-cement

2 Brass

4 Galvanized steel

6 Concrete tile

8 RMP (SR)

11 Other (specify)

SCREEN OR PERFORATION OPENINGS ARE:

1 Continuous slot

3 Mill slot

5 Gauzed wrapped

8 Saw cut

11 None (open hole)

2 Louvered shutter

4 Key punched

6 Wire wrapped

9 Drilled holes

7 Torch cut

10 Other (specify)

SCREEN-PERFORATED INTERVALS: From 29 ft. to 48 ft., From 29 ft. to 48 ft., From 29 ft. to 48 ft.

GRAVEL PACK INTERVALS: From 13 ft. to 48 ft., From 13 ft. to 48 ft., From 13 ft. to 48 ft.

6 GROUT MATERIAL:

1 Neat cement

2 Cement grout

3 Bentonite

4 Other SURFACE SOIL 0-3 FT

Grout Intervals: From 3 ft. to 13 ft., From 0 ft. to 3 ft., From 0 ft. to 3 ft.

What is the nearest source of possible contamination:

1 Septic tank

4 Lateral lines

7 Pit privy

10 Livestock pens

14 Abandoned water well

2 Sewer lines

5 Cess pool

8 Sewage lagoon

11 Fuel storage

15 Oil well/Gas well

3 Watertight sewer lines

6 Seepage pit

9 Feedyard

12 Fertilizer storage

16 Other (specify below)

13 Insecticide storage

Direction from well? WEST

How many feet? 60

| FROM | TO | LITHOLOGIC LOG      | FROM | TO | LITHOLOGIC LOG |
|------|----|---------------------|------|----|----------------|
| 0    | 6  | SURFACE SOIL        |      |    |                |
| 6    | 22 | CLAY                |      |    |                |
| 22   | 30 | SAND AND CLAY MIXED |      |    |                |
| 30   | 48 | SAND                |      |    |                |
| 48   |    | SHALE               |      |    |                |

7 CONTRACTOR'S OR LANDOWNER'S CERTIFICATION: This water well was (1) constructed, (2) reconstructed, or (3) plugged under my jurisdiction and was completed on (mo/day/year) 12-13-82 and this record is true to the best of my knowledge and belief. Kansas

Water Well Contractor's License No. 437 This Water Well Record was completed on (mo/day/yr) 12-28-82

under the business name of RALPH THEISER WELL DIGGER DALLAS (signature) Ralph S. Theiser

INSTRUCTIONS: Use typewriter or ball point pen, PLEASE PRESS FIRMLY and PRINT clearly. Please fill in blanks, underline or circle the correct answers. Send top three copies to Kansas Department of Health and Environment, Division of Environment, Environmental Geology Section, Topeka, KS 66620. Send one to WATER WELL OWNER and retain one for your records.