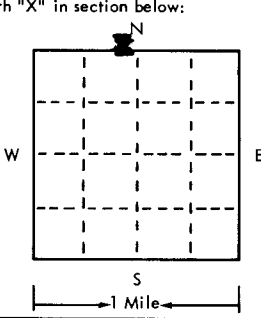


USE TYPEWRITER OR BALL
POINT PEN-PRESS FIRMLY,
PRINT CLEARLY.

WATER WELL RECORD
KSA 82a-1201-1215

T R EW sec 1/4 1/4 1/4 No.

Kansas State Dept. Of Health
(Water Well Contractors)
Forbes-Bldg. 740
Topeka, Kansas 66620

1 Location of well:	County Sedgwick	Township name Waco NE	Fraction NE 1/4 NW 1/4	Section number 24	Town number 28S	Range number 1W
Distance and direction from nearest town or city: 3245 West 47th So.		3 Owner of well: Clint Renollet				
Street address of well location if in city: Wichita, Ks.		Address: 3245 West 47th Street South Wichita, Kansas				
Locate with "X" in section below: 		Sketch map:		4 Well depth: 50 ft. Date of completion 7-18-75 Well diameter 11 in.		
2 Type and color of material		From	To	5 ☐ Cable tool ☒ Rotary ☐ Driven ☐ Dug ☐ Hollow rod ☐ Jetted ☐ Bored ☐ Reverse rotary		
Sandy Top Soil		0	2	6 Use: ☒ Domestic ☐ Public supply ☐ Industry ☐ Irrigation ☐ Air conditioning ☐ Commercial ☐ Test well ☐		
Clay		2	18	7 Casing: Material styrene Height: 12 in. Threaded ☐ Welded ☐ Surface ☐ Diam. 5 in. Weight 12 lbs./ft. 5 in. to 50 ft. depth Drive shoe? ☐ Yes ☐ No 5 in. to 50 ft. depth		
Fine Sand		18	35	8 Screen: Manufacturer Sunflower Plastic Type styrene Dia. 5" Slot/gauze .005 Length 10' Set between 40 ft. and 50 ft. Fittings: Gravel pack ☒ Yes ☐ No Size range of material 1-1/8"		
Medium Sand		35	50	9 Static water level: 15 ft. below land surface Date 7-18-75		
				10 Pumping level below land surfaces: ____ ft. after ____ hrs. pumping ____ g.p.m. ____ ft. after ____ hrs. pumping ____ g.p.m. Estimated maximum yield ____ g.p.m.		
				11 Water sample submitted: ☐ Yes ☐ No Date ____		
				12 Well head completion: ☒ Pitless adapter 12 inches above grade		
				13 Well grouted? ☒ Yes ☐ No ☒ Neat cement ☐ Bentonite ☐ Depth: From 0 ft. to 10 ft.		
				14 Nearest source of possible contamination: ft. 90 Direction SE Type Septic tank Well disinfected upon completion? ☒ Yes ☐ No		
				15 Pump: ☒ Not installed Manufacturer's name Sta-Rite Model number LP6D2 HP 3/4 Volts 230 Length of drop pipe 40 ft. capacity 20 g.m.p. Type: ☒ Submersible ☐ Turbine ☐ Jet ☐ Reciprocating ☐ Centrifugal ☐ Other		
16 Remarks: elevation Flat Ground		17 Water well contractor's certification: This well was drilled under my jurisdiction and this report is true to the best of my knowledge and belief. Harp Well & Pump 236 Business name License No. 67209 Address Wichita, Kansas Signed Clint Renollet Date 7-19-75 Authorized representative				

Forward the white, blue and pink copies to the Kansas State Dept. Of Health.

Form WWC-5