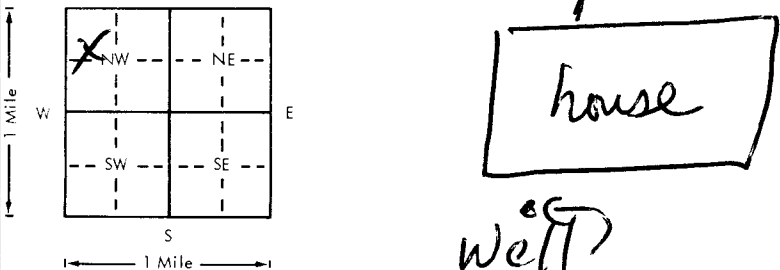


USE TYPEWRITER OR BALL POINT PEN-PRESS FIRMLY, PRINT CLEARLY.

WATER WELL RECORD
KSA 82a-1201-1215

Kansas Department of Health and Environment-Division of Environment
(Water well Contractors)
Topeka, Kansas 66620

1. Location of well: County Ledgewick Fraction SW 1/4 NW 1/4 NW 1/4 Section number 24 Township number T 28 S R Range number EW	
2. Distance and direction from nearest town or city: Street address of well location if in city: 3930 W Fairhaven W. KS 3. Owner of well: Clint Renollet R.R. or street: 3245 W 47th So. City, state, zip code: Wichita KS 67217	
4. Locate with "X" in section below: Sketch map: Septu 	
5. Type and color of material	
From	To
Top soil.	0 3
Red clay	3 20
fine sand	20 32
red clay	32 33
med to coarse gravel	33 55
6. Bore hole dia. 4 in. Completion date 4/2/79 Well depth 55 ft.	
7. <input checked="" type="checkbox"/> Cable tool <input checked="" type="checkbox"/> Rotary <input type="checkbox"/> Driven <input type="checkbox"/> Dug <input type="checkbox"/> Hollow rod <input type="checkbox"/> Jetted <input type="checkbox"/> Bored <input type="checkbox"/> Reverse rotary	
8. Use: <input checked="" type="checkbox"/> Domestic <input type="checkbox"/> Public supply <input type="checkbox"/> Industry <input type="checkbox"/> Irrigation <input type="checkbox"/> Air conditioning <input type="checkbox"/> Stock <input type="checkbox"/> Oil field water <input type="checkbox"/> Other	
9. Casing: Septu Height above or below 0 Threaded <input checked="" type="checkbox"/> Welded <input type="checkbox"/> Surface 1.13 in. RMP <input checked="" type="checkbox"/> PVC Weight 1.50 lbs./ft. Dia. 5 in. to 55 ft. depth Wall Thickness: inches or Dia. 2.00 in. to 20 ft. depth gauge No. 200	
10. Screen: Manufacturer's name Sunflower Type 200 Dia. 5/8 Screen gauge 1 1/8 Length 6 ft Set between 4 ft and 5 ft Gravel pack <input checked="" type="checkbox"/> Yes range of material 3/8	
11. Static water level: 10 ft. below land surface Date 4/2/79 no./day/yr.	
12. Pumping level below land surfaces: 20 ft. after 1/2 hrs. pumping 15 g.p.m. ft. after 1 hrs. pumping 15 g.p.m. Estimated maximum yield 30-50 g.p.m.	
13. Water sample submitted: X Yes X No Date	
14. Well head completion: <input checked="" type="checkbox"/> Pitless adapter 4 1/2 inches above grade	
15. Well grouted? Yes With: <input type="checkbox"/> Neat cement <input type="checkbox"/> Bentonite <input checked="" type="checkbox"/> Concrete Depth: From 3 ft. to 13 ft.	
16. Nearest source of possible contamination: Septu ft. 55 Direction No Type Septu Well disinfected upon completion? <input checked="" type="checkbox"/> Yes <input type="checkbox"/> No	
17. Pump: FW Not installed Manufacturer's name FW Model number 50AT HP 1/2 Volts 220 Length of drop pipe 30 ft. capacity 10 g.p.m. Type: <input checked="" type="checkbox"/> Submersible <input type="checkbox"/> Turbine <input type="checkbox"/> Jet <input type="checkbox"/> Reciprocating <input type="checkbox"/> Centrifugal <input type="checkbox"/> Other	
(Use a second sheet if needed)	
18. Elevation:	19. Remarks: Customer to furnish 4x4x4" slab around well at grade Per State Regulations Signed X Clint Renollet
Topography: <input type="checkbox"/> Hill <input type="checkbox"/> Slope <input checked="" type="checkbox"/> Upland <input type="checkbox"/> Valley	20. Water well contractor's certification: This well was drilled under my jurisdiction and this report is true to the best of my knowledge and belief. Wminger Co 318 Business name Wminger Co License No. Address Ledgewick KS Signed John Wminger Date 4/2/79 Authorized representative

28-10-24 Submittal

Forward the white, blue and pink copies to the Department of Health and Environment

Form WWC-5