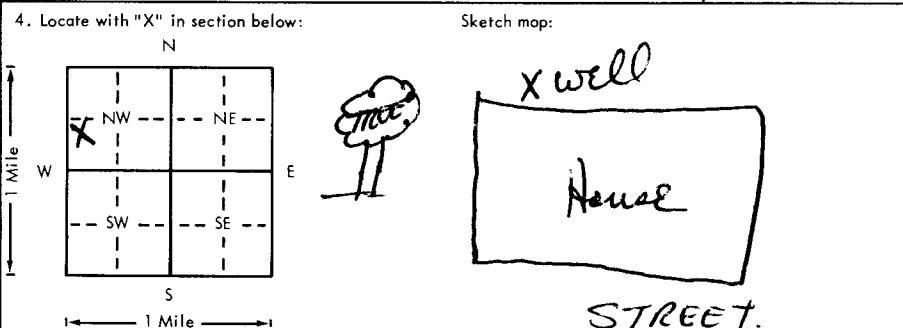


USE TYPEWRITER OR BALL POINT PEN-PRESS FIRMLY, PRINT CLEARLY.

WATER WELL RECORD
KSA 82a-1201-1215

Kansas Department of Health and Environment-Division of Environment (Water well Contractors) Topeka, Kansas 66620

SE SE NW NW

1. Location of well:		County Sedgwick	Fraction NW 1/4 SW 1/4 NW 1/4	Section number 24	Township number T 28 S R 1W E/W	Range number
2. Distance and direction from nearest town or city: Street address of well location if in city: 3501 W. FAIRHAVEN			3. Owner of well: R.R. or street: City, state, zip code:			
4. Locate with "X" in section below: 			6. Bore hole dia. 1 1/2 in. Completion date 7-18-79 Well depth 30 ft.			
5. Type and color of material			7. <input type="checkbox"/> Cable tool <input type="checkbox"/> Rotary <input checked="" type="checkbox"/> Driven <input type="checkbox"/> Dug <input type="checkbox"/> Hollow rod <input type="checkbox"/> Jetted <input checked="" type="checkbox"/> Bored <input type="checkbox"/> Reverse rotary			
			8. Use: <input checked="" type="checkbox"/> Domestic <input type="checkbox"/> Public supply <input type="checkbox"/> Industry <input type="checkbox"/> Irrigation <input type="checkbox"/> Air conditioning <input type="checkbox"/> Stock <input type="checkbox"/> Low <input type="checkbox"/> Oil field water <input type="checkbox"/> Other			
			9. Casing: Material PVC Height: Above or below Threaded <input type="checkbox"/> Welded <input type="checkbox"/> Surface 12 in. RMP <input type="checkbox"/> PVC <input checked="" type="checkbox"/> Weight 2-750 lbs./ft. Dia. 5 in. to 30 ft. depth Wall Thickness: inches Dia. <input type="checkbox"/> in. to <input type="checkbox"/> ft. depth gage No. 1257			
			10. Screen: Manufacturer's name Modern Rpt Co. Type PVC Dia. 5.563 Slot/gouze .025 Length 5 Set between 25 ft. and 30 ft. Gravel pack? <input checked="" type="checkbox"/> No Size range of material			
			11. Static water level: 20 ft. below land surface Date			
			12. Pumping level below land surfaces: 20 ft. after 1 hrs. pumping 15 g.p.m. ft. after hrs. pumping g.p.m. Estimated maximum yield 30 g.p.m.			
			13. Water sample submitted: <input checked="" type="checkbox"/> Yes <input type="checkbox"/> No Date			
			14. Well head completion: <input type="checkbox"/> Pitless adapter 12 Inches above grade			
			15. Well grouted? YES With: <input checked="" type="checkbox"/> Neat cement <input type="checkbox"/> Bentonite <input type="checkbox"/> Concrete Depth: From 0 ft. to 10 ft.			
			16. Nearest source of possible contamination: ft. 10 Direction N Type old well Well disinfected upon completion? <input checked="" type="checkbox"/> Yes <input type="checkbox"/> No			
			17. Pump: <input checked="" type="checkbox"/> Not installed Manufacturer's name Model number HP Volts Length of drop pipe ft. capacity g.p.m. Type: <input type="checkbox"/> Submersible <input type="checkbox"/> Turbine <input type="checkbox"/> Jet <input type="checkbox"/> Reciprocating <input type="checkbox"/> Centrifugal <input type="checkbox"/> Other			
18. Elevation: Topography: <input type="checkbox"/> Hill <input type="checkbox"/> Slope <input checked="" type="checkbox"/> Upland <input checked="" type="checkbox"/> Valley			19. Remarks: Customer to pour concrete slab. Signature on file			
			20. Water well contractor's certification: This well was drilled under my jurisdiction and this report is true to the best of my knowledge and belief. 21st Electric <input checked="" type="checkbox"/> 129 Business name Signature No. Address 512 W. 21st Wichita Signed J. Harris Date 5-14-79 Authorized representative			

28
1
R
1
W
24
Sec
1/4
1/4
1/4
1/4

Forward the white, blue and pink copies to the Department of Health and Environment

Form WWC-5