USE TYPEWRITER OR BALL POINT PEN-PRESS FIRMLY, PRINT CLEARLY.

WATER WELL RECORD
KSA 82a-1201-1215

Kansas Department of Health and Environment-Division of Environment
(Water well Contractors)
Topeka, Kansas 66620

1. Location of well: County: Sedgwick. Fraction: SW 1/4 NW 1/4 NW 1/4 Section number: 24 Township number: T 28 S Range number: R 1 E (W)

2. Distance and direction from nearest town or city:
Street address of well location if in city: 3931 W. Fairhaven Wichita Ks

3. Owner of well: Clint. Renollet
R.R. or street: 3245 W. 47th So
City, state, zip code: Wichita Ks 67217

4. Locate with "X" in section below:

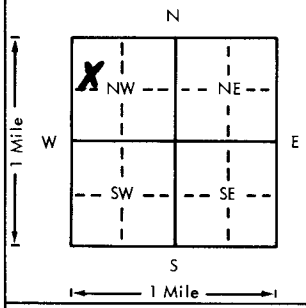

Sketch map:

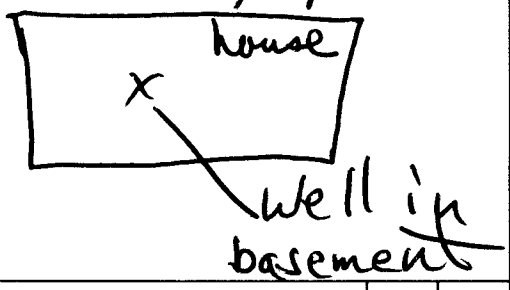

6. Bore hole dia. ___ in. Completion date 6/5/78
Well depth 48 ft.

7. __ Cable tool X Rotary __ Driven __ Dug
__ Hollow rod __ Jetted __ Bored __ Reverse rotary

8. Use: X Domestic __ Public supply __ Industry
__ Irrigation __ Air conditioning __ Stock
__ Lawn & __ Oil field water __ Other

9. Casing: Material Steel Height: Above or below
Threaded __ Welded X Surface 0.12 in.
RMP X PVC __ Weight 1.50 lbs./ft.
Dia. 5 in. to 48 ft. depth Wall Thickness: inches or
Dio. ___ in. to ___ ft. depth gage No. 200

10. Screen: Manufacturer's name Sunflower
Type 209 Dia. 5 in
Slot/gauze 110 Length 5 ft
Set between 43 ft. and 48 ft.
___ ft. and ___ ft.
Gravel pack? yes Size range of material 3/8

11. Static water level:
16 ft. below land surface Date 6/5/78 mo./day/yr.

12. Pumping level below land surfaces:
18 ft. after 1/2 hrs. pumping 15 g.p.m.
___ ft. after ___ hrs. pumping ___ g.p.m.
Estimated maximum yield 40 g.p.m.

13. Water sample submitted: mo./day/yr.
__ Yes X No Date

14. Well head completion:
__ Pitless adapter 12 inches above grade

15. Well grouted? yes
With: __ Neat cement __ Bentonite X Concrete
Depth: From 6 ft. to 16 ft.

16. Nearest source of possible contamination: X
ft. 60 Direction Septic
Well disinfected upon completion? X Yes __ No

17. Pump: X Not installed
Manufacturer's name
Model number HP Volts
Length of drop pipe ft. capacity g.p.m.
Type:
__ Submersible __ Turbine
__ Jet __ Reciprocating
__ Centrifugal __ Other

5. Type and color of material

	From	To
Top Soil	0	2
Red clay.	2	16
fine sand.	16	33
gray ~~red~~ clay	33	34
fine to med. sand.	34	48
gray clay -	48	

(Use a second sheet if needed)

18. Elevation:

Topography:
__ Hill
__ Slope
X Upland
__ Valley

19. Remarks:

20. Water well contractor's certification:
This well was drilled under my jurisdiction and this report is true to the best of my knowledge and belief.
Wenger Drilling 318
Business name License No.
Address Colwich
Signature Authorized representative Date 6/5/78

Forward the white, blue and pink copies to the Department of Health and Environment

Form WWC-5

28 T 1 R (W) 24 Sec SW 1/4 NW 1/4 NW 1/4

M1-1023