


1 LOCATION OF WATER WELL: County: Sedgwick Fraction: SW $\frac{1}{4}$ NW $\frac{1}{4}$ Section Number: 24 Township Number: T 28 S Range Number: R 1 E

Distance and direction from nearest town or city street address of well if located within city?

See Below.

2 WATER WELL OWNER: DEAN TULL
RR#, St. Address, Box #: 4906 So Wesley
City, State, ZIP Code: Wichita, KS
Board of Agriculture, Division of Water Resources
Application Number:

3 LOCATE WELL'S LOCATION WITH AN "X" IN SECTION BOX:

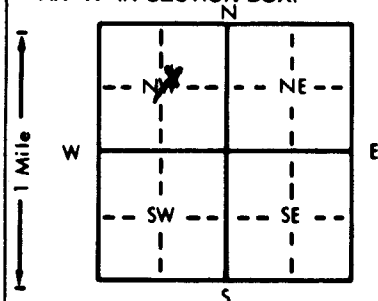

4 DEPTH OF COMPLETED WELL: 50 ft. ELEVATION:

Depth(s) Groundwater Encountered 1. 24 ft. 2. 24 ft. 3. 24 ft.

WELL'S STATIC WATER LEVEL 24 ft. below land surface measured on mo/day/yr 7-29-86

Pump test data: Well water was 24 ft. after 20 hours pumping 20 gpm

Est. Yield 60 gpm: Well water was 24 ft. after 20 hours pumping 20 gpm

Bore Hole Diameter 11 in. to 50 ft. and 50 in. to 50 ft.

WELL WATER TO BE USED AS: 5 Public water supply 8 Air conditioning 11 Injection well

1 Domestic 3 Feedlot 6 Oil field water supply 9 Dewatering 12 Other (Specify below)

2 Irrigation 4 Industrial 7 Lawn and garden only 10 Observation well

Was a chemical/bacteriological sample submitted to Department? Yes X No X

Water Well Disinfected? Yes X No X

5 TYPE OF BLANK CASING USED: 5 Wrought iron 8 Concrete tile CASING JOINTS: Glued X Clamped X

1 Steel 3 RMP (SR) 6 Asbestos-Cement 9 Other (specify below) Welded X

2 PVC 4 ABS 7 Fiberglass Threaded X

Blank casing diameter 5 in. to 40 ft. Dia. 40 in. to 40 ft. Dia. 40 in. to 40 ft.

Casing height above land surface 12 in. weight 1.59 lbs./ft. Wall thickness or gauge No SDR-26

TYPE OF SCREEN OR PERFORATION MATERIAL: 7 PVC 10 Asbestos-cement

1 Steel 3 Stainless steel 5 Fiberglass 8 RMP (SR) 11 Other (specify)

2 Brass 4 Galvanized steel 6 Concrete tile 9 ABS 12 None used (open hole)

SCREEN OR PERFORATION OPENINGS ARE: 5 Gauzed wrapped 8 Saw cut 11 None (open hole)

1 Continuous slot 3 Mill slot 6 Wire wrapped 9 Drilled holes

2 Louvered shutter 4 Key punched 7 Torch cut 10 Other (specify)

SCREEN-PERFORATED INTERVALS: From 40 ft. to 50 ft. From 40 ft. to 50 ft.

GRAVEL PACK INTERVALS: From 13 ft. to 50 ft. From 13 ft. to 50 ft.



6 GROUT MATERIAL: 1 Neat cement 2 Cement grout 3 Bentonite 4 Other

Grout intervals: From 3 ft. to 13 ft. From 3 ft. to 13 ft.

What is the nearest source of possible contamination: 10 Livestock pens 14 Abandoned water well

1 Septic tank 4 Lateral lines 7 Pit privy 11 Fuel storage 15 Oil well/Gas well

2 Sewer lines 5 Cess pool 8 Sewage lagoon 12 Fertilizer storage 16 Other (specify below)

3 Watertight sewer lines 6 Seepage pit 9 Feedyard 13 Insecticide storage

Direction from well? South How many feet? 90

FROM TO LITHOLOGIC LOG FROM TO LITHOLOGIC LOG

0 2 Top soil

2 18 Clay

18 31 fine sand

31 32 Clay

32 50 gravel


7 CONTRACTOR'S OR LANDOWNER'S CERTIFICATION: This water well was (1) constructed, (2) reconstructed, or (3) plugged under my jurisdiction and was completed on (mo/day/year) 7-29-86 and this record is true to the best of my knowledge and belief. Kansas

Water Well Contractor's License No. 318 This Water Well Record was completed on (mo/day/yr) 8-7-86

under the business name of Weninger Dull by (signature) [Signature]

INSTRUCTIONS: Use typewriter or ball point pen. PLEASE PRESS FIRMLY and PRINT clearly. Please fill in blanks, underline or circle the correct answers. Send top three copies to Kansas

Department of Health and Environment, Office of Field and Environmental Geology, Regulation and Permitting Section, Topeka, Kansas 66620-1500, Telephone: 913-862-9360. Send one

to WATER WELL OWNER and retain one for your records.