


1 LOCATION OF WATER WELL: County: Seton Fraction: NW 1/4 NW 1/4 NW 1/4 Section Number: 27 Township Number: T 28 S Range Number: R 1 E/W

Distance and direction from nearest town or city street address of well if located within city?

same

2 WATER WELL OWNER: Robert Orr
 RR#, St. Address, Box #: 4905 S. Kisselton
 City, State, ZIP Code: Wich. KS.
 Board of Agriculture, Division of Water Resources
 Application Number:

3 LOCATE WELL'S LOCATION WITH AN "X" IN SECTION BOX:

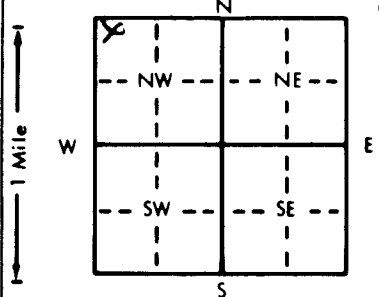

4 DEPTH OF COMPLETED WELL: 50 ft. ELEVATION: 1200
 Depth(s) Groundwater Encountered: 1 20 ft. 2. 20 ft. 3. 64-93 ft.
 WELL'S STATIC WATER LEVEL: 20 ft. below land surface measured on mo/day/yr 64-93
 Pump test data: Well water was 20 ft. after 4 hours pumping 15 gpm
 Est. Yield 30 gpm: Well water was 20 ft. after 4 hours pumping 15 gpm
 Bore Hole Diameter: 12 in. to 50 ft. and 50 in. to 50 ft.
 WELL WATER TO BE USED AS:
 1 Domestic 3 Feedlot 6 Oil field water supply 9 Dewatering 12 Other (Specify below)
 2 Irrigation 4 Industrial 7 Lawn and garden only 10 Monitoring well
 Was a chemical/bacteriological sample submitted to Department? Yes X No X If yes, mo/day/yr sample was submitted
 Water Well Disinfected? Yes X No X

5 TYPE OF BLANK CASING USED:
 1 Steel 3 RMP (SR)
 2 PVC 4 ABS
 5 Wrought iron 8 Concrete tile CASING JOINTS: Glued X Clamped X
 6 Asbestos-Cement 9 Other (specify below) Welded X
 7 Fiberglass Threaded X
 Casing height above land surface: 12 in., weight 5 lbs/ft lbs./ft. Wall thickness or gauge No. 160
 TYPE OF SCREEN OR PERFORATION MATERIAL:
 1 Steel 3 Stainless steel 5 Fiberglass 8 RMP (SR)
 2 Brass 4 Galvanized steel 6 Concrete tile 9 ABS 10 Asbestos-cement
 11 Other (specify) X
 12 None used (open hole)
 SCREEN OR PERFORATION OPENINGS ARE:
 1 Continuous slot 3 Mill slot 5 Gauzed wrapped 8 Saw cut 11 None (open hole)
 2 Louvered shutter 4 Key punched 6 Wire wrapped 9 Drilled holes
 7 Torch cut 10 Other (specify) X

6 GROUT MATERIAL: 1 Neat cement 2 Cement grout 3 Bentonite 4 Other
 What is the nearest source of possible contamination: N/A
 1 Septic tank 4 Lateral lines 7 Pit privy 10 Livestock pens 14 Abandoned water well
 2 Sewer lines 5 Cess pool 8 Sewage lagoon 11 Fuel storage 15 Oil well/Gas well
 3 Watertight sewer lines 6 Seepage pit 9 Feedyard 12 Fertilizer storage 16 Other (specify below)
 13 Insecticide storage
 Direction from well? How many feet?

| FROM | TO | LITHOLOGIC LOG | FROM | TO | PLUGGING INTERVALS |
|------|----|----------------|------|----|--------------------|
| 0 | 2 | TOP SOIL | | | |
| 2 | 18 | Red clay | | | |
| 18 | 30 | med SAND | | | |
| 30 | 50 | GRAVEL | | | |

7 CONTRACTOR'S OR LANDOWNER'S CERTIFICATION: This water well was (1) constructed, (2) reconstructed, or (3) plugged under my jurisdiction and was completed on (mo/day/year) 6-4-93 and this record is true to the best of my knowledge and belief. Kansas Water Well Contractor's License No. 463 This Water Well Record was completed on (mo/day/yr) 6-23-93 under the business name of RCA by (signature) David P. [Signature]