USE TYPEWRITER OR BALL POINT PEN-PRESS FIRMLY, PRINT CLEARLY.

WATER WELL RECORD
KSA 82a-1201-1215

Kansas Department of Health and Environment-Division of Environment
(Water well Contractors)
Topeka, Kansas 66620

1. Location of well:	County	Fraction	Section number	Township number	Range number
	Sedgwick	SW 1/4 SW 1/4 NE 1/4	33	T 28 S	R 1 ~~E~~ W

2. Distance and direction from nearest town or city: 3 mi West of Haysville
Street address of well location if in city:

3. Owner of well: Abbott Laboratories
R.R. or street: 6601 S. 71 West
City, state, zip code: Wichita, Kansas 67215

4. Locate with "X" in section below:

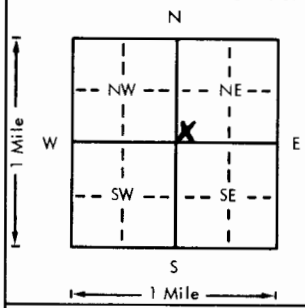

Sketch map: Well No. 3

5. Type and color of material	From	To
Top soil	0	2
Brown clay	2	10
Sandy red clay	10	20
Med. sand & gravel	20	30
Tan clay	30	40
Fine sand	40	45
Fine sand w/clay streaks	45	65
Gray-black clay	65	110
Med. sand & gravel	110	131

(Use a second sheet if needed)

6. Bore hole dia. 18 in. Completion date
Well depth 131 ft. 4/22/80

7. __ Cable tool __ Rotary __ Driven __ Dug
__ Hollow rod __ Jetted __ Bored X Reverse rotary

8. Use: __ Domestic __ Public supply X Industry
__ Irrigation __ Air conditioning __ Stock
__ Lawn __ Oil field water __ Other

9. Casing: Material steel Height: Above ~~below~~
Threaded ___ Welded X Surface 12 in.
RMP ___ PVC ___ Weight 24.7 lbs./ft.
Dia. 8 in. 111 ft. depth Wall Thickness: inches or
Dia. ___ in. to ___ ft. depth gage No. .277

10. Screen: Manufacturer's name Mustang
Type Wire Wrap Dia. 8"
Slot/gauze #70-#60 Length 20'
Set between 111 ft. and 131 ft.
___ ft. and ___ ft.
Gravel pack? Yes Size range of material 1/8 x 1/2

11. Static water level: mo./day/yr.
50'2" ft. below land surface Date 3/21/80

12. Pumping level below land surfaces:
59 ft. after 1 hrs. pumping 178 g.p.m.
___ ft. after ___ hrs. pumping ___ g.p.m.
Estimated maximum yield 250 g.p.m.

13. Water sample submitted: mo./day/yr.
__ Yes X No Date

14. Well head completion:
X Pitless adapter ___ inches above grade

15. Well grouted? yes
With: ___ Neat cement ___ Bentonite X Concrete
Depth: From 21 ft. to 3 ft.

16. Nearest source of possible contamination:
ft. 2000 Direction East Type Pond
Well disinfected upon completion? X Yes ___ No

17. Pump: ___ Not installed
Manufacturer's name Layne & Bowler
Model number 6DRELMC HP 5 Volts 480
Length of drop pipe 105 ft. capacity 100 g.p.m.
Type:
X Submersible ___ Turbine
___ Jet ___ Reciprocating
___ Centrifugal ___ Other

18. Elevation:

Topography:
___ Hill
___ Slope
X Upland
___ Valley

19. Remarks:

20. Water well contractor's certification:
This well was drilled under my jurisdiction and this report is true to the best of my knowledge and belief.
Layne Western Co. 102
Business name License No.
Address Wichita, Kansas
Signed [signature] Date 4/23/80
Authorized representative

T ___ R ___ E W ___ Sec ___ 1/4 ___ 1/4 ___ 1/4 ___

Forward the white, blue and pink copies to the Department of Health and Environment

Form WWC-5

MI-1023