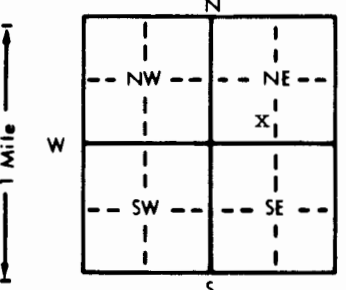


1 LOCATION OF WATER WELL: County: Sedgwick		Fraction SE 1/4 SW 1/4 NE 1/4	Section Number 35	Township Number T 29 28 S	Range Number R 1 EW
Distance and direction from nearest town or city street address of well if located within city? 63 St in Wichita KS					
2 WATER WELL OWNER: RR#, St. Address, Box # : City, State, ZIP Code :		Vulcan Materials Company Chemicals Division P.O. Box 12283 Wichita, KS 67277 Board of Agriculture, Division of Water Resources Application Number: N/A			
3 LOCATE WELL'S LOCATION WITH AN "X" IN SECTION BOX: 		4 DEPTH OF COMPLETED WELL 62' ft. ELEVATION: Depth(s) Groundwater Encountered 1. 41' ft. 2. ft. 3. ft. WELL'S STATIC WATER LEVEL ft. below land surface measured on mo/day/yr Pump test data: Well water was ft. after hours pumping gpm Est. Yield gpm: Well water was ft. after hours pumping gpm Bore Hole Diameter in. to ft., and in. to ft. WELL WATER TO BE USED AS: 1 Domestic 3 Feedlot 5 Public water supply 8 Air conditioning 11 Injection well 2 Irrigation 4 Industrial 6 Oil field water supply 9 Dewatering 12 Other (Specify below) <u>test hole</u> 7 Lawn and garden only 10 Monitoring well Was a chemical/bacteriological sample submitted to Department? Yes No; If yes, mo/day/yr sample was submitted Water Well Disinfected? Yes No			
5 TYPE OF BLANK CASING USED: 1 Steel 3 RMP (SR) 2 PVC 4 ABS Blank casing diameter 2 1/2 in. to ft., Dia in. to ft. Casing height above land surface 4' Below in., weight lbs./ft. Wall thickness or gauge No.		5 Wrought iron 8 Concrete tile CASING JOINTS: Glued Clamped 6 Asbestos-Cement 9 Other (specify below) Welded 7 Fiberglass Threaded			
TYPE OF SCREEN OR PERFORATION MATERIAL: 1 Steel 3 Stainless steel 5 Fiberglass 8 RMP (SR) 11 Asbestos-cement 2 Brass 4 Galvanized steel 6 Concrete tile 9 ABS 12 Other (specify) (open hole) SCREEN OR PERFORATION OPENINGS ARE: 1 Continuous slot 3 Mill slot 5 Gauzed wrapped 8 Saw cut 11 None (open hole) 2 Louvered shutter 4 Key punched 7 Wire wrapped 9 Drilled holes 7 Torch cut 10 Other (specify)		SCREEN-PERFORATED INTERVALS: From ft. to ft., From ft. to ft. GRAVEL PACK INTERVALS: From ft. to ft., From ft. to ft.			
6 GROUT MATERIAL: 1 Neat cement 2 Cement grout 3 Bentonite 4 Other Grout Intervals: From ft. to ft., From 62 ft. to 62 ft., From ft. to ft. What is the nearest source of possible contamination: 1 Septic tank 4 Lateral lines 7 Pit privy 10 Livestock pens 14 Abandoned water well 2 Sewer lines 5 Cess pool 8 Sewage lagoon 11 Fuel storage 15 Oil well/Gas well 3 Watertight sewer lines 6 Seepage pit 9 Feedyard 12 Fertilizer storage 16 Other (specify below) 13 Insecticide storage None Known Direction from well? How many feet?		FROM TO LITHOLOGIC LOG FROM TO PLUGGING INTERVALS 62 4 Cement Grout Note Casing was cemented annular space to SWL When Drilled			
7 CONTRACTOR'S OR LANDOWNER'S CERTIFICATION: This water well was (1) constructed, (2) reconstructed, or (3) plugged under my jurisdiction and was completed on (mo/day/year) 1-17-89 and this record is true to the best of my knowledge and belief. Kansas Water Well Contractor's License No. 185 This Water Well Record was completed on (mo/day/yr) 3/7/89 under the business name of Clarke Well & Equipment, Inc. by (signature)					