

PLUGGING 2111011

WATER WELL RECORD

Form WWC-5

KSA 82a-1212

1 LOCATION OF WATER WELL:	Fraction	Section Number	Township Number	Range Number
County: SEDGWICK	SE 1/4 SE 1/4 NE 1/4	11	T 28 S	R 1 E

Distance and direction from nearest town or city street address of well if located within city?

3511 S. WEST STREET


2 WATER WELL OWNER: ASPHALT CONSTRUCTION CO.

RR#, St. Address, Box #: 3511 S. WEST ST.
City, State, ZIP Code: WICHITA, KS 67217

Board of Agriculture, Division of Water Resources

Application Number:

3 LOCATE WELL'S LOCATION WITH AN "X" IN SECTION BOX:

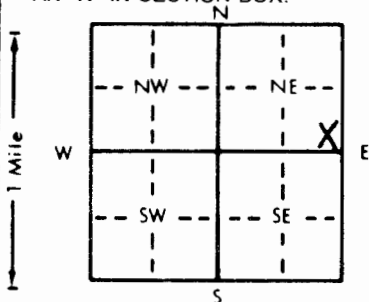

4 DEPTH OF COMPLETED WELL: 48.5 ft. ELEVATION:

Depth(s) Groundwater Encountered 1. 15 ft. 2. ft. 3. ft.

WELL'S STATIC WATER LEVEL ft. below land surface measured on mo/day/yr

Pump test data: Well water was ft. after hours pumping gpm

Est. Yield gpm: Well water was ft. after hours pumping gpm

Bore Hole Diameter in. to ft. and in. to ft.

WELL WATER TO BE USED AS: 5 Public water supply 8 Air conditioning 11 Injection well

1 Domestic 3 Feedlot 6 Oil field water supply 9 Dewatering 12 Other (Specify below)

2 Irrigation 4 Industrial 7 Lawn and garden only 10 Monitoring well

Was a chemical/bacteriological sample submitted to Department? No. If yes, mo/day/yr sample was submitted

Water Well Disinfected? Yes No

5 TYPE OF BLANK CASING USED:

- 1 Steel
2 PVC
3 RMP (SR)
4 ABS

- 5 Wrought iron
6 Asbestos-Cement
7 Fiberglass
8 Concrete tile
9 Other (specify below)

CASING JOINTS: Glued Clamped
Welded
Threaded

Blank casing diameter 4 in. to ft. Dia. in. to ft. Dia. in. to ft.

Casing height above land surface FL45H in. weight lbs./ft. Wall thickness or gauge No.

TYPE OF SCREEN OR PERFORATION MATERIAL:

- 1 Steel
2 Brass
3 Stainless steel
4 Galvanized steel

- 5 Fiberglass
6 Concrete tile
7 PVC
8 RMP (SR)
9 ABS

- 10 Asbestos-cement
11 Other (specify)
12 None used (open hole)

SCREEN OR PERFORATION OPENINGS ARE:

- 1 Continuous slot
2 Louvered shutter
3 Mill slot
4 Key punched

- 5 Gauzed wrapped
6 Wire wrapped
7 Torch cut

- 8 Saw cut
9 Drilled holes
10 Other (specify)
11 None (open hole)

SCREEN-PERFORATED INTERVALS: From ft. to ft. From ft. to ft. From ft. to ft.

From ft. to ft. From ft. to ft. From ft. to ft.

GRAVEL PACK INTERVALS: From ft. to ft. From ft. to ft. From ft. to ft.

From ft. to ft. From ft. to ft. From ft. to ft.

6 GROUT MATERIAL:

- 1 Neat cement
2 Cement grout
3 Bentonite
4 Other

Grout Intervals: From ft. to ft. From ft. to ft. From ft. to ft. From ft. to ft.

What is the nearest source of possible contamination:

- 1 Septic tank
2 Sewer lines
3 Watertight sewer lines
4 Lateral lines
5 Cess pool
6 Seepage pit
7 Pit privy
8 Sewage lagoon
9 Feedyard

- 10 Livestock pens
11 Fuel storage
12 Fertilizer storage
13 Insecticide storage
14 Abandoned water well
15 Oil well/Gas well
16 Other (specify below)

Direction from well? NA

How many feet? NA

FROM	TO	LITHOLOGIC LOG	FROM	TO	PLUGGING INTERVALS
			0.0	15	BENTONITE
			15	48.5	SAND

7 CONTRACTOR'S OR LANDOWNER'S CERTIFICATION: This water well was (1) constructed, (2) reconstructed, or (3) plugged under my jurisdiction and was completed on (mo/day/year) 6-29-94 and this record is true to the best of my knowledge and belief. Kansas

Water Well Contractor's License No. 531 This Water Well Record was completed on (mo/day/yr) 7-6-94

under the business name of GSI

by (signature) Mike Simpson

INSTRUCTIONS. Use typewriter or ball point pen. PLEASE PRESS FIRMLY and PRINT clearly. Please fill in blanks, underline or circle the correct answers. Send top three copies to Kansas Department of Health and Environment, Bureau of Water, Topeka, Kansas 66620-0001. Telephone: 913-296-5545. Send one to WATER WELL OWNER and retain one for your records.