

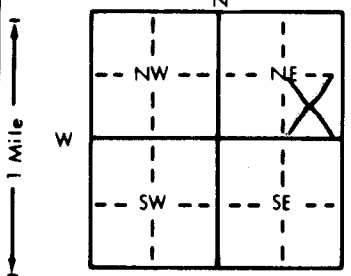
1 LOCATION OF WATER WELL: County: <u>Sedgwick</u>	Fraction <u>N.N. 1/4 S.E. 1/4 N.E. 1/4</u>	Section Number <u>1</u>	Township Number <u>T 28 S</u>	Range Number <u>R 1 E.W.</u>
--	---	----------------------------	----------------------------------	---------------------------------

Distance and direction from nearest town or city street address of well if located within city?

2808 W. Anita

PLUGGING REPORT

2 WATER WELL OWNER: <u>Lanny Snedaker</u> RR#, St. Address, Box #: <u>2808 W. Anita</u> City, State, ZIP Code: <u>Wichita K.S. 67217</u>	Board of Agriculture, Division of Water Resources Application Number:
--	--

3 LOCATE WELL'S LOCATION WITH AN "X" IN SECTION BOX: 	4 DEPTH OF COMPLETED WELL: <u>15</u> ft. ELEVATION: Depth(s) Groundwater Encountered 1. ft. 2. ft. 3. ft. WELL'S STATIC WATER LEVEL <u>10</u> ft. below land surface measured on mo/day/yr <u>7-31-94</u> Pump test data: Well water was ft. after hours pumping gpm Est. Yield gpm: Well water was ft. after hours pumping gpm Bore Hole Diameter <u>2 1/2</u> in. to ft. and in. to ft. WELL WATER TO BE USED AS: 5 Public water supply 8 Air conditioning 11 Injection well 1 Domestic 3 Feedlot 6 Oil field water supply 9 Dewatering 12 Other (Specify below) 2 Irrigation 4 Industrial <u>1 Lawn and garden only</u> 10 Monitoring well Was a chemical/bacteriological sample submitted to Department? Yes No If yes, mo/day/yr sample was submitted Water Well Disinfected? <u>Yes X</u> No
--	--

5 TYPE OF BLANK CASING USED: <u>1 Steel</u> 3 RMP (SR) 2 PVC 4 ABS Blank casing diameter <u>2</u> in. to ft. Dia. in. to ft. Dia. in. to ft. Casing height above land surface <u>15' below</u> weight lbs./ft. Wall thickness or gauge No. TYPE OF SCREEN OR PERFORATION MATERIAL: <u>1 Steel</u> 3 Stainless steel 5 Fiberglass 7 PVC 10 Asbestos-cement 2 Brass 4 Galvanized steel 6 Concrete tile 9 ABS 12 None used (open hole) SCREEN OR PERFORATION OPENINGS ARE: 1 Continuous slot 3 Mill slot 5 Gauzed wrapped 8 Saw cut 11 None (open hole) 2 Louvered shutter 4 Key punched 6 Wire wrapped 9 Drilled holes SCREEN-PERFORATED INTERVALS: From ft. to ft. From ft. to ft. GRAVEL PACK INTERVALS: From ft. to ft. From ft. to ft.	CASING JOINTS: Glued Clamped Welded <u>Threaded</u>
--	---

6 GROUT MATERIAL: <u>1 Neat cement</u> 2 Cement grout 3 Bentonite 4 Other Grout Intervals: From <u>3</u> ft. to <u>0</u> ft. From ft. to ft. From ft. to ft. What is the nearest source of possible contamination: 1 Septic tank 4 Lateral lines 7 Pit privy 10 Livestock pens 14 Abandoned water well <u>2 Sewer lines</u> 5 Cess pool 8 Sewage lagoon 11 Fuel storage 15 Oil well/Gas well 3 Watertight sewer lines 6 Seepage pit 9 Feedyard 12 Fertilizer storage 16 Other (specify below) 13 Insecticide storage Direction from well? <u>North</u> How many feet? <u>7 1/2'</u>
--

FROM	TO	LITHOLOGIC LOG	FROM	TO	PLUGGING INTERVALS
			<u>15</u>	<u>10</u>	<u>Sand Gravel</u>
			<u>10</u>	<u>3</u>	<u>SOIL</u>
			<u>3</u>	<u>0</u>	<u>Neat Cement 0.06</u>
			<u>0</u>	<u>3</u>	<u>Neat Cement 0.06</u>
			<u>3</u>	<u>10</u>	<u>Soil</u>
			<u>10</u>	<u>15</u>	<u>Sand Gravel</u>

7 CONTRACTOR'S OR LANDOWNER'S CERTIFICATION: This water well was (1) constructed, (2) reconstructed, or (3) plugged under my jurisdiction and was completed on (mo/day/year) <u>7-31-94</u> and this record is true to the best of my knowledge and belief. Kansas Water Well Contractor's License No. This Water Well Record was completed on (mo/day/yr) under the business name of by (signature) <u>Lanny Snedaker</u>
--