

NW SE SW

WATER WELL RECORD

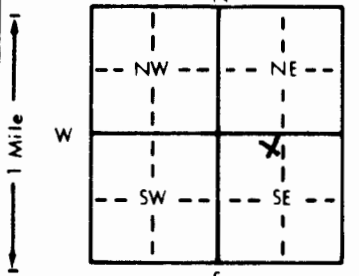
Form WWC-5

KSA 82a-1212

MW 2

1 LOCATION OF WATER WELL: County: SEDGWICK	Fraction NE 1/4 NW 1/4 SE 1/4	Section Number 1	Township Number T 28 S	Range Number R 1 E
Distance and direction from nearest town or city street address of well if located within city?				

2 WATER WELL OWNER: RR#, St. Address, Box # : 3400 W 30TH SOUTH - WICHITA KS. 67203 City, State, ZIP Code :	BUS FACILITY Board of Agriculture, Division of Water Resources Application Number:
--	---

3 LOCATE WELL'S LOCATION WITH AN "X" IN SECTION BOX: 	4 DEPTH OF COMPLETED WELL: 15 ft. ELEVATION: Depth(s) Groundwater Encountered 1. 10.7 ft. 2. - ft. 3. - ft. WELL'S STATIC WATER LEVEL 7.6 ft. below land surface measured on mo/day/yr 08-23-94 Pump test data: Well water was NA ft. after - hours pumping - gpm Est. Yield NA gpm: Well water was - ft. after - hours pumping - gpm Bore Hole Diameter 8.625 in. to 15 ft. and - in. to - ft. WELL WATER TO BE USED AS: 5 Public water supply 8 Air conditioning 11 Injection well 1 Domestic 3 Feedlot 6 Oil field water supply 9 Dewatering 12 Other (Specify below) 2 Irrigation 4 Industrial 7 Lawn and garden only 10 Monitoring well Was a chemical/bacteriological sample submitted to Department? Yes - No X If yes, mo/day/yr sample was submitted - Water Well Disinfected? Yes - No X
--	---

5 TYPE OF BLANK CASING USED: 1 Steel 3 RMP (SR) 5 Wrought iron 8 Concrete tile 2 PVC 4 ABS 6 Asbestos-Cement 9 Other (specify below) Blank casing diameter 2 in. to 5 ft. Dia - in. to - ft. Dia - in. to - ft. Casing height above land surface 0 in. weight SCH 40 lbs./ft. Wall thickness or gauge No. - TYPE OF SCREEN OR PERFORATION MATERIAL: 1 Steel 3 Stainless steel 5 Fiberglass 7 PVC 10 Asbestos-cement 2 Brass 4 Galvanized steel 6 Concrete tile 8 RMP (SR) 11 Other (specify) SCREEN OR PERFORATION OPENINGS ARE: 1 Continuous slot 3 Mill slot 5 Gauzed wrapped 8 Saw cut 11 None (open hole) 2 Louvered shutter 4 Key punched 6 Wire wrapped 9 Drilled holes SCREEN-PERFORATED INTERVALS: From 5 ft. to 15 ft. From - ft. to - ft. SAND From - ft. to - ft. From - ft. to - ft. GRAVEL PACK INTERVALS: From 4 ft. to 15 ft. From - ft. to - ft. From - ft. to - ft. From - ft. to - ft.

6 GROUT MATERIAL: 1 Neat cement 2 Cement grout 3 Bentonite 4 Other Grout Intervals: From 2 ft. to 2 ft. From 2 ft. to 4 ft. From - ft. to - ft. What is the nearest source of possible contamination: 1 Septic tank 4 Lateral lines 7 Pit privy 10 Livestock pens 14 Abandoned water well 2 Sewer lines 5 Cess pool 8 Sewage lagoon 11 Fuel storage 15 Oil well/Gas well 3 Watertight sewer lines 6 Seepage pit 9 Feedyard 12 Fertilizer storage 16 Other (specify below) 13 Insecticide storage Direction from well? N How many feet? 30
--

FROM	TO	LITHOLOGIC LOG	FROM	TO	PLUGGING INTERVALS
0	1	ASPHALT & GRAVEL			
1	2	SILTY CLAY			
2	6	CLAY SILT			
6	10	SILTY CLAY			
10	15	SILTY SAND			
TD	15				
FLUSH MOUNT NAIVER					
08-16-94 DON TAYLOR					

7 CONTRACTOR'S OR LANDOWNER'S CERTIFICATION: This water well was (1) constructed, (2) reconstructed, or (3) plugged under my jurisdiction and was completed on (mo/day/year) 08-22-94 and this record is true to the best of my knowledge and belief. Kansas Water Well Contractor's License No. 479 This Water Well Record was completed on (mo/day/yr) 09-13-94 under the business name of EBBERTS DRILLING by (signature) <i>Shogun Ebberts</i>
--