

SE SWSW NW

WATER WELL RECORD

Form WWC-5

KSA 82K-1212


Plugging Report

1 LOCATION OF WATER WELL:	Fraction	Section Number	Township Number	Range Number
County: Sedgwick	SE 1/4 SE 1/4 NE 1/4	13	T 28 S	R 7 E

Distance and direction from nearest town or city street address of well if located within city?

2 WATER WELL OWNER:	Board of Agriculture, Division of Water Resources
RR#, St. Address, Box #	Application Number:
City, State, ZIP Code	

3 LOCATE WELL'S LOCATION WITH AN "X" IN SECTION BOX:	4 DEPTH OF COMPLETED WELL	ft. ELEVATION:
--	---------------------------	----------------

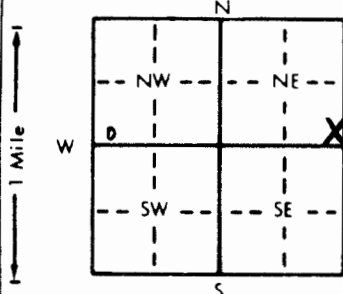

Depth(s) Groundwater Encountered 15 ft. 2. ft. 3. ft.

WELL'S STATIC WATER LEVEL 15 ft. below land surface measured on mo/day/yr 10-27-94

Pump test data: Well water was ft. after hours pumping gpm

Est. Yield gpm: Well water was ft. after hours pumping gpm

Bore Hole Diameter in. to ft. and in. to ft.

WELL WATER TO BE USED AS: 5 Public water supply 8 Air conditioning 11 Injection well

1 Domestic 3 Feedlot 6 Oil field water supply 9 Dewatering 12 Other (Specify below)

2 Irrigation 4 Industrial 7 Lawn and garden only 10 Monitoring well

Was a chemical/bacteriological sample submitted to Department? Yes No If yes, mo/day/yr sample was submitted

5 TYPE OF BLANK CASING USED:	5 Wrought iron	8 Concrete tile	CASING JOINTS: Glued Clamped
------------------------------	----------------	-----------------	------------------------------

1 Steel	3 RMP (SR)	6 Asbestos-Cement	9 Other (specify below)	Welded
---------	------------	-------------------	-------------------------	--------

2 PVC	4 ABS	7 Fiberglass		Threaded
-------	-------	--------------	--	----------

Blank casing diameter 5 in. Dia. in. to ft. Dia. in. to ft.

Casing height above land surface 2 ft. Below weight lbs./ft. Wall thickness or gauge No.

TYPE OF SCREEN OR PERFORATION MATERIAL:	7 PVC	10 Asbestos-cement
---	-------	--------------------

1 Steel	3 Stainless steel	5 Fiberglass	8 RMP (SR)	11 Other (specify) NA
---------	-------------------	--------------	------------	-----------------------

2 Brass	4 Galvanized steel	6 Concrete tile	9 ABS	12 None used (open hole)
---------	--------------------	-----------------	-------	--------------------------

SCREEN OR PERFORATION OPENINGS ARE:	5 Gauzed wrapped	8 Saw cut	11 None (open hole)
-------------------------------------	------------------	-----------	---------------------

1 Continuous slot	3 Mill slot	6 Wire wrapped	9 Drilled holes
-------------------	-------------	----------------	-----------------

2 Louvered shutter	4 Key punched	7 Torch cut	10 Other (specify) NA
--------------------	---------------	-------------	-----------------------

SCREEN-PERFORATED INTERVALS:	From NA ft. to NA ft.	From NA ft. to NA ft.
------------------------------	-----------------------	-----------------------

From NA ft. to NA ft.	From NA ft. to NA ft.	From NA ft. to NA ft.
-----------------------	-----------------------	-----------------------

GRAVEL PACK INTERVALS:	From NA ft. to NA ft.	From NA ft. to NA ft.
------------------------	-----------------------	-----------------------

From NA ft. to NA ft.	From NA ft. to NA ft.	From NA ft. to NA ft.
-----------------------	-----------------------	-----------------------

6 GROUT MATERIAL:	1 Neat cement	2 Cement grout	3 Bentonite	4 Other
-------------------	---------------	----------------	-------------	---------

Grout Intervals:	From 25 ft. to 10 ft.	From NA ft. to NA ft.	From NA ft. to NA ft.
------------------	-----------------------	-----------------------	-----------------------

What is the nearest source of possible contamination:

1 Septic tank	4 Lateral lines	7 Pit privy	10 Livestock pens	14 Abandoned water well
---------------	-----------------	-------------	-------------------	-------------------------

2 Sewer lines	5 Cess pool	8 Sewage lagoon	11 Fuel storage	15 Oil well/Gas well
---------------	-------------	-----------------	-----------------	----------------------

3 Watertight sewer lines	6 Seepage pit	9 Feedyard	12 Fertilizer storage	16 Other (specify below)
--------------------------	---------------	------------	-----------------------	--------------------------

Direction from well? East	How many feet? 10	Termite Treatment
---------------------------	-------------------	-------------------

FROM	TO	LITHOLOGIC LOG	FROM	TO	PLUGGING INTERVALS
------	----	----------------	------	----	--------------------

			25	10	Cement
--	--	--	----	----	--------

			10	0	gravel
--	--	--	----	---	--------

--	--	--	--	--	--

--	--	--	--	--	--

7 CONTRACTOR'S OR LANDOWNER'S CERTIFICATION: This water well was (1) constructed, (2) reconstructed, or (3) plugged under my jurisdiction and was completed on (mo/day/year) 10-27-94 and this record is true to the best of my knowledge and belief. Kansas

Water Well Contractor's License No. 318 This Water Well Record was completed on (mo/day/yr) 10-3-94

under the business name of Weninger Drilling by (signature) Karina Morissey

INSTRUCTIONS: Use typewriter or ball point pen. PLEASE PRESS FIRMLY and PRINT clearly. Please fill in blanks, underline or circle the correct answers. Send top three copies to Kansas Department of Health and Environment, Bureau of Water, Topeka, Kansas 66620-0001. Telephone: 913-296-5545. Send one to WATER WELL OWNER and retain one for your records.