


1 LOCATION OF WATER WELL:		Fraction		Section Number		Township Number		Range Number	
County:	Sedgwick	NE ¼	NE ¼	NW ¼	1	T 28 S	R 1 W E/W		

Distance and direction from nearest town or city street address of well if located within city?

3215 W. Pawnee, Wichita

2	WATER WELL OWNER:	Central States Express	
	RR#, St. Address, Box # :	P.O. Box 2250	Board of Agriculture, Division of Water Resources
	City, State, ZIP Code :	Bowling Green, Kentucky 42102	Application Number:

3 LOCATE WELL'S LOCATION WITH AN "X" IN SECTION BOX: 4 DEPTH OF COMPLETED WELL 18 ft. ELEVATION: 1292.6

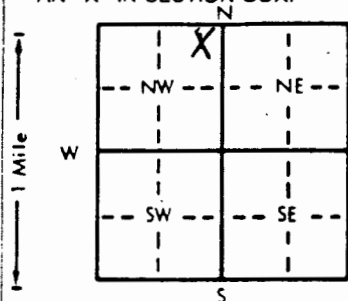

4 DEPTH OF COMPLETED WELL 18 ft. ELEVATION:
 Depth(s) Groundwater Encountered 1. 11. ft. 2. ft. 3. 1292.6 ft.
 WELL'S STATIC WATER LEVEL 10.8 ft. below land surface measured on mo/day/yr 2/2/95
 Pump test data: Well water was ft. after hours pumping gpm
 Est. Yield . . . NA . . . gpm: Well water was ft. after hours pumping gpm
 Bore Hole Diameter 8 . . . in. to 20 . . . ft., and in. to ft.
 WELL WATER TO BE USED AS: 5 Public water supply 8 Air conditioning 11 Injection well
 1 Domestic 3 Feedlot 6 Oil field water supply 9 Dewatering 12 Other (Specify below)
 2 Irrigation 4 Industrial 7 Lawn and garden only 10 Monitoring well
 Was a chemical/bacteriological sample submitted to Department? Yes..... No..... X.....; If yes, mo/day/yr sample was sub-
 mitted Water Well Disinfected? Yes No X

5 TYPE OF BLANK CASING USED:		5 Wrought iron	8 Concrete tile	CASING JOINTS: Glued Clamped
1 Steel	3 RMP (SR)	6 Asbestos-Cement	9 Other (specify below)	Welded
② PVC	4 ABS	7 Fiberglass		Threaded. X
Blank casing diameter 2 in. to 8 ft., Dia		 in. to ft., Dia in. to ft.		
Casing height above land surface 4.3 in., weight lbs./ft.		Wall thickness or gauge No. Sch. 40		

TYPE OF SCREEN OR PERFORATION MATERIAL:

1 Steel	3 Stainless steel	5 Fiberglass	7 PVC	10 Asbestos-cement
2 Brass	4 Galvanized steel	6 Concrete tile	8 RMP (SR)	11 Other (specify)
			9 ABS	12 None used (open hole)

SCREEN OR PERFORATION OPENINGS ARE:

1 Continuous slot	3 Mill slot	5 Gauzed wrapped	8 Saw cut	11 None (open hole)
2 Louvered shutter	4 Key punched	6 Wire wrapped	9 Drilled holes	
		7 Torch cut	10 Other (specify)	

SCREEN-PERFORATED INTERVALS: From 8 ft. to 18 ft., From ft. to ft.
From ft. to ft., From ft. to ft.
GRAVEL PACK INTERVALS: From 6 ft. to 20 ft., From ft. to ft.
From ft. to ft. From ft. to ft.

6 GROUT MATERIAL: 1 Neat cement 2 Cement grout 3 Bentonite 4 Other
Grout Intervals: From 0 ft. to 4 ft. From 4 ft. to 6 ft. From ft. to ft.

What is the nearest source of possible contamination:

1 Septic tank	4 Lateral lines	7 Pit privy	10 Livestock pens	14 Abandoned water well
2 Sewer lines	5 Cess pool	8 Sewage lagoon	11 Fuel storage	15 Oil well/Gas well
3 Watertight sewer lines	6 Seepage pit	9 Feedyard	12 Fertilizer storage	16 Other (specify below)
			13 Insecticide storage	UST

Direction from well?	SW	How many feet?	60
----------------------	----	----------------	----

[illegible]

7 CONTRACTOR'S OR LANDOWNER'S CERTIFICATION: This water well was (1) constructed, (2) reconstructed, or (3) plugged under my jurisdiction and was completed on (mo/day/year) 2/12/95 and this record is true to the best of my knowledge and belief. Kansas Water Well Contractor's License No. 527 This Water Well Record was completed on (mo/day/yr) 3/1/95 under the business name of GeoCore Services, Inc. by (signature) Dale G. Hall