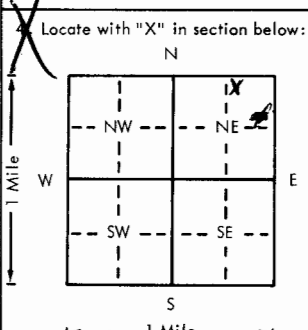


USE TYPEWRITER OR BALL
POINT PEN-PRESS FIRMLY,
PRINT CLEARLY.

WATER WELL RECORD
KSA 82a-1201-1215

Kansas Department of Health and
Environment-Division of Environment
(Water well Contractors)
Topeka, Kansas 66620

1. Location of well:		County Kingman	Fraction nw 1/4 nw 1/4 ne 1/4	Section number 1	Township number T 28 S	Range number R 10W E/W
2. Distance and direction from nearest town or city: 3 1/2 mi. Cunningham			3. Owner of well: Gray Miller R.R. or street: Cunningham, Ks. City, state, zip code:			
4. Locate with "X" in section below: 		Sketch map:		6. Bore hole dia. 8 in. Completion date 7-25-79 Well depth 25 ft.		
5. Type and color of material		From	To	7. <input checked="" type="checkbox"/> Cable tool <input checked="" type="checkbox"/> Rotary <input type="checkbox"/> Driven <input type="checkbox"/> Dug <input type="checkbox"/> Hollow rod <input type="checkbox"/> Jetted <input type="checkbox"/> Bored <input type="checkbox"/> Reverse rotary		
soil and sand		0	9	<input checked="" type="checkbox"/> Use: <input checked="" type="checkbox"/> Domestic <input type="checkbox"/> Public supply <input type="checkbox"/> Industry <input type="checkbox"/> Irrigation <input type="checkbox"/> Air conditioning <input type="checkbox"/> Stock <input type="checkbox"/> Lawn <input type="checkbox"/> Oil field water <input type="checkbox"/> Other		
silty sand		9	12	9. Casing: Material <input type="checkbox"/> Height: Above or below Threaded <input type="checkbox"/> Welded <input type="checkbox"/> Surface 15 in. RMP <input type="checkbox"/> PVC <input checked="" type="checkbox"/> Weight 282 lbs./ft. Dia. 5 in. to 25 ft. depth Wall thickness: inches or Dia. <input type="checkbox"/> in. to <input type="checkbox"/> ft. depth gage No. 258		
clay and silty sand		12	18	10. Screen: Manufacturer's name Pumpco Type pvc Dia. 5 1/2 Slot/gauze slot Length 10 Set between 15 ft. and 25 ft. ft. and 1/2 in. ft.		
fine clean sand		18	25	Gravel pack? <input checked="" type="checkbox"/> Size range of material 2 an		
				11. Static water level: <input type="checkbox"/> mo./day/yr. 8 ft. below land surface Date 7-6-79		
				12. Pumping level below land surfaces: ft. after <input type="checkbox"/> hrs. pumping <input type="checkbox"/> g.p.m. ft. after <input type="checkbox"/> hrs. pumping <input type="checkbox"/> g.p.m. Estimated maximum yield 50 g.p.m.		
				13. Water sample submitted: <input type="checkbox"/> mo./day/yr. <input type="checkbox"/> Yes <input checked="" type="checkbox"/> No Date		
				14. Well head completion: <input checked="" type="checkbox"/> Pitless adapter 15 Inches above grade		
				15. Well grouted? <input checked="" type="checkbox"/> With <input checked="" type="checkbox"/> Neat cement <input type="checkbox"/> Bentonite <input type="checkbox"/> Concrete Depth: From 4 ft. to 15 ft.		
				16. Nearest source of possible contamination: ft. <input type="checkbox"/> Direction Pasture type <input type="checkbox"/> Well disinfected upon completion? <input checked="" type="checkbox"/> Yes <input type="checkbox"/> No		
				17. Pump: <input type="checkbox"/> Not installed Manufacturer's name Jacuzzi Model number 5S4B H.P. 1/2 Volts 230 Length of drop pipe 15 ft. capacity 15 g.p.m. Type: <input checked="" type="checkbox"/> Submersible <input type="checkbox"/> Turbine <input type="checkbox"/> Jet <input type="checkbox"/> Reciprocating <input type="checkbox"/> Centrifugal <input type="checkbox"/> Other		
		(Use a second sheet if needed)				
18. Elevation:		19. Remarks:		20. Water well contractor's certification: This well was drilled under my jurisdiction and this report is true to the best of my knowledge and belief. Lyman Bros. 140 Business name License No. Address ML Signed W H Lyman Date 8-25-79 Authorized representative		
Topography: <input type="checkbox"/> Hill <input type="checkbox"/> Slope <input type="checkbox"/> Upland <input checked="" type="checkbox"/> Valley		Customer tp pour slab				