

1 LOCATION OF WATER WELL:	Fraction	Section Number	Township Number	Range Number
County: <u>Kingman</u>	<u>SW 1/4 SW 1/4 SE 1/4</u>	<u>17</u>	<u>T 28 S</u>	<u>R 10 EW</u>

Distance and direction from nearest town or city street address of well if located within city?

2 South, .5 West of Cunningham, Ks.2 WATER WELL OWNER: Leonard Willinger

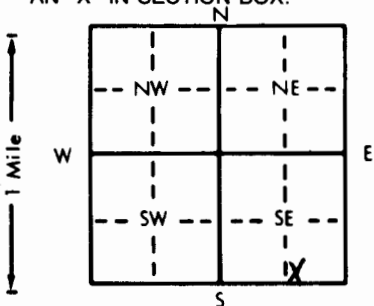
RR#, St. Address, Box # :

Board of Agriculture, Division of Water Resources

City, State, ZIP Code : Cunningham, Ks. 67035

Application Number:

3 LOCATE WELL'S LOCATION WITH AN "X" IN SECTION BOX:

4 DEPTH OF COMPLETED WELL: 114 ft. ELEVATION: flatDepth(s) Groundwater Encountered 1. 35 ft. 2. ft. 3. ft.WELL'S STATIC WATER LEVEL 35 ft. below land surface measured on mo/day/yr 9/5/84Pump test data: Well water was ft. after hours pumping gpmEst. Yield 6.5 gpm: Well water was ft. after hours pumping gpmBore Hole Diameter 10 in. to 114 ft., and in. to ft.

WELL WATER TO BE USED AS: 5 Public water supply 8 Air conditioning 11 Injection well

1 Domestic x 3 Feedlot 6 Oil field water supply 9 Dewatering 12 Other (Specify below)

2 Irrigation 4 Industrial 7 Lawn and garden only 10 Observation well

Was a chemical/bacteriological sample submitted to Department? Yes No x; If yes, mo/day/yr sample was submittedWater Well Disinfected? Yes x No

5 TYPE OF BLANK CASING USED:

1 Steel 3 RMP (SR)

2 PVC x 4 ABS

5 Wrought iron

6 Asbestos-Cement

7 Fiberglass

8 Concrete tile

9 Other (specify below)

CASING JOINTS: Glued x Clamped

Welded

Threaded

Blank casing diameter 5 in. to 104 ft., Dia in. to ft., Dia in. to ft.Casing height above land surface 14 in., weight 160 lbs./ft. Wall thickness or gauge No. SDR 26

TYPE OF SCREEN OR PERFORATION MATERIAL:

1 Steel 3 Stainless steel

2 Brass 4 Galvanized steel

5 Fiberglass

6 Concrete tile

7 PVC x

8 RMP (SR)

9 ABS

10 Asbestos-cement

11 Other (specify)

12 None used (open hole)

SCREEN OR PERFORATION OPENINGS ARE:

1 Continuous slot

3 Mill slot

2 Louvered shutter

4 Key punched

5 Gauzed wrapped

6 Wire wrapped

7 Torch cut

8 Saw cut x

9 Drilled holes

10 Other (specify)

11 None (open hole)

SCREEN-PERFORATED INTERVALS: From 104 ft. to 114 ft., From ft. to ft.From ft. to ft., From ft. to ft.GRAVEL PACK INTERVALS: From 74 ft. to 114 ft., From ft. to ft.From ft. to ft., From ft. to ft.

6 GROUT MATERIAL:

1 Neat cement x

2 Cement grout

3 Bentonite

4 Other

Grout Intervals: From 4 ft. to 14 ft., From ft. to ft., From ft. to ft.

What is the nearest source of possible contamination:

1 Septic tank x

4 Lateral lines

7 Pit privy

10 Livestock pens

14 Abandoned water well

2 Sewer lines

5 Cess pool

8 Sewage lagoon

11 Fuel storage

15 Oil well/Gas well

3 Watertight sewer lines 6 Seepage pit

9 Feedyard

12 Fertilizer storage

16 Other (specify below)

13 Insecticide storage

Direction from well? SEHow many feet? over 50'

FROM	TO	LITHOLOGIC LOG	FROM	TO	LITHOLOGIC LOG
0	23	earth & clay			
23	35	coarse gravel			
35	47	fine sand, some clay			
47	60	gyp clay			
60	63	fine sand			
63	74	clay			
74	78	sand			
78	87	clay			
87	92	sand			
92	101	clay			
101	104	fine sand			
104	114	coarse sand			

7 CONTRACTOR'S OR LANDOWNER'S CERTIFICATION: This water well was (1) constructed, (2) reconstructed, or (3) plugged under my jurisdiction and was completed on (mo/day/year) 9/5/84 and this record is true to the best of my knowledge and belief. KansasWater Well Contractor's License No. 103 This Water Well Record was completed on (mo/day/yr) 11/1/84under the business name of Hank Bruse Water Well Serviceby (signature) Hank Bruse

INSTRUCTIONS: Use typewriter or ball point pen, PLEASE PRESS FIRMLY and PRINT clearly. Please fill in blanks, underline or circle the correct answers. Send top three copies to Kansas Department of Health and Environment, Division of Environment, Environmental Geology Section, Topeka, KS 66620. Send one to WATER WELL OWNER and retain one for your records.