


USE TYPEWRITER OR BALL POINT PEN-PRESS FIRMLY, PRINT CLEARLY.

WATER WELL RECORD
KSA 82a-1201-1215

Kansas Department of Health and Environment-Division of Environment (Water well Contractors) Topeka, Kansas 66620

1. Location of well: County Kingman Fraction NE 1/4 SW 1/4 SE 1/4 Section number 36 Township number T 28 S R 10W E/W Range number

2. Distance and direction from nearest town or city: 6S 3 3/4 E 3. Owner of well: S.G. Adelhardt
Street address of well location if in city: 1/4 N of Cunningham Kansas R.R. or street:
City, state, zip code: Nashville, Kansas

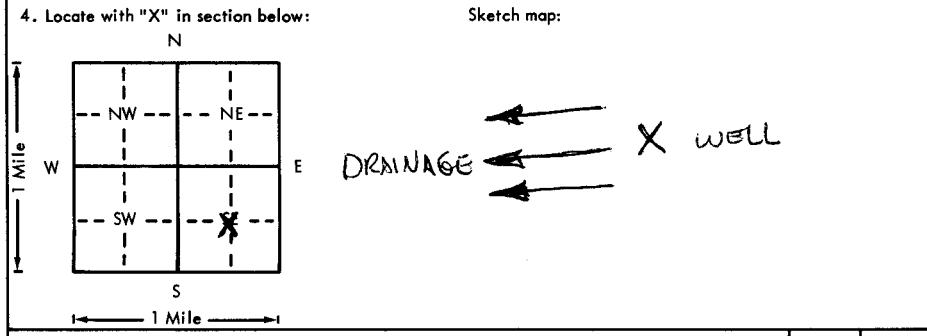

6. Bore hole dia. 28 in. Completion date _____
Well depth 137 ft. 1 July 76

7. Cable tool Rotary Driven Dug
 Hollow rod Jetted Bored Reverse rotary

8. Use: Domestic Public supply Industry
 Irrigation Air conditioning Stock
 Lawn Oil field water Other

9. Casing: Material Stl Height Above or below
Threaded Welded Surface 12 in.
RMP PVC Weight _____ lbs./ft.
Dia. 16 in. to 79 ft. depth; Wall thickness: inches or
Dia. _____ in. to _____ ft. depth; gage No. 188

5. Type and color of material	From	To
Soil	0	3
Clay, tan	3	10
Sand, fine	10	14
Clay, tan	14	29
Sand, fine to coarse and medium gravel	29	44
Clay, tan and cemented sand	44	60
Sand, fine to coarse and fine gravel	60	73
Sand, fine to coarse and medium gravel	73	106
Sand, fine to coarse	106	135
Shale, red	135	140
(Use a second sheet if needed)		

10. Screen: Manufacturer's name W.A. Brown
Type Freeflo Dia. 16"
Slot gauze 1/8" Length 58'
Set between 79 ft. and 137 ft.
Gravel pack? yes Size range of material 1/2 x 1/8

11. Static water level: _____ mo./day/yr.
56 ft. below land surface Date _____

12. Pumping level below land surfaces:
71 ft. after 1 hrs. pumping 776 g.p.m.
76 ft. after 1 hrs. pumping 882 g.p.m.
Estimated maximum yield 1400 g.p.m.

13. Water sample submitted: _____ mo./day/yr.
 Yes No Date _____

14. Well head completion: _____
 Pitless adapter _____ Inches above grade

15. Well grouted? xx
With: Neat cement Bentonite Concrete
Depth: From 0 ft. to 10 ft.

16. Nearest source of possible contamination:
ft. _____ Direction _____ Type None
Well disinfected upon completion? Yes No

17. Pump: _____ Not installed
Manufacturer's name Floway
Model number 12DOL HP 80 Volts _____
Length of drop pipe 100 ft. capacity 800 g.p.m.
Type: Submersible Turbine
 Jet Reciprocating
 Centrifugal Other

18. Elevation: _____
Topography: _____ Hill _____ Slope Upland _____ Valley

19. Remarks: Concrete base poured by S.G. Adelhardt

20. Water well contractor's certification:
This well was drilled under my jurisdiction and this report is true to the best of my knowledge and belief.
Central Well & Pump 325
Business name _____ License No. _____
Address 121 S. Taylor
Signed B. Honnicksell Date 19 July 76
Authorized representative

2-8-1-00W-3-6-1/4 NE SW SE 1/4