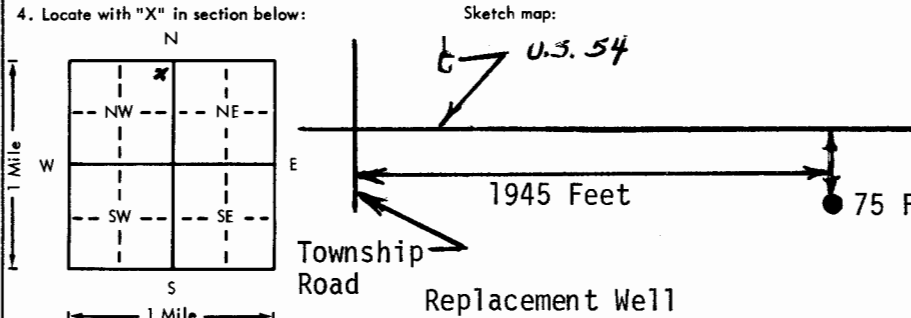


USE TYPEWRITER OR BALL  
POINT PEN-PRESS FIRMLY,  
PRINT CLEARLY.

WATER WELL RECORD  
KSA 82a-1201-1215

Kansas Department of Health and  
Environment-Division of Environment  
(Water well Contractors)  
Topeka, Kansas 66620

1. Location of well:	County <b>Pratt</b>	Fraction <b>NE 1/4 NE 1/4 NW 1/4</b>	Section number <b>3</b>	Township number <b>T 28 S R 11W</b>	Range number <b>XXX</b>
2. Distance and direction from nearest town or city: <b>Four West of Cunningham, Kansas</b> Street address of well location if in city:			3. Owner of well: <b>Kansas Dept. of Transportation</b> R.R. or street: <b>State Office Building</b> City, state, zip code: <b>Topeka, Kansas 66612</b>		
4. Locate with "X" in section below: 			6. Bore hole dia. <b>12</b> in. Completion date <b>1-9-81</b> Well depth <b>98</b> ft.		
5. Type and color of material			7. <input type="checkbox"/> Cable tool <input checked="" type="checkbox"/> Rotary <input type="checkbox"/> Driven <input type="checkbox"/> Dug <input type="checkbox"/> Hollow rod <input type="checkbox"/> Jetted <input type="checkbox"/> Bored <input type="checkbox"/> Reverse rotary		
Sandy silty clay			8. Use: <input type="checkbox"/> Domestic <input checked="" type="checkbox"/> Public supply <input type="checkbox"/> Industry <input type="checkbox"/> Irrigation <input type="checkbox"/> Air conditioning <input type="checkbox"/> Stock <input type="checkbox"/> Lawn <input type="checkbox"/> Oil field water <input type="checkbox"/> Other		
Sand, f to med., few coarse zones, clean			9. Casing: Material <input type="checkbox"/> Height: Above <b>XXX</b> Threaded <input type="checkbox"/> Welded <input type="checkbox"/> Surface <b>3.8</b> ft. RMP <input type="checkbox"/> PVC <input checked="" type="checkbox"/> Weight <b>3.584</b> lbs./ft. Dia. <input type="checkbox"/> in. to <input type="checkbox"/> ft. depth; Wall Thickness: inches or Dia. <input type="checkbox"/> in. to <input type="checkbox"/> ft. depth; gage No. <b>0.280</b>		
Sand, f to med., thin clay zones			10. Screen: Manufacturer's name <b>Pumpco</b> <b>Regular slotted, Sch. No. 40</b> Type <b>PVC</b> Dia. <b>6" ID</b> Slot/gauze <input type="checkbox"/> Length <b>30.0</b> Feet Set between <b>63.0</b> ft. and <b>93.0</b> ft. <input type="checkbox"/> ft. and <input type="checkbox"/> ft.		
Silty clay, tan			Gravel pack? <b>Yes</b> Size range of material <b>1/16-3/8</b>		
Sand, f. to Med., clean			11. Static water level: <input type="checkbox"/> mo./day/yr. <b>9.2</b> ft. below land surface Date <b>1-9-81</b>		
Silty clay, caliche, tan			12. Pumping level below land surfaces: <b>11.2</b> ft. after <b>7</b> hrs. pumping <b>30</b> g.p.m. <input type="checkbox"/> ft. after <input type="checkbox"/> hrs. pumping <input type="checkbox"/> g.p.m. Estimated maximum yield <b>80 to 100</b> g.p.m.		
Sand, f. to c., clean			13. Water sample submitted: <input checked="" type="checkbox"/> Yes <input type="checkbox"/> No Date <b>1-12-81</b>		
Sand, f. to med., thin coarse sand & clay zone			14. Well head completion: Be completed later <input type="checkbox"/> Pitless adapter <input type="checkbox"/> Inches above grade		
Silty clay, caliche, tan			15. Well grouted? <b>Yes *</b> With: <input checked="" type="checkbox"/> Neat cement <input checked="" type="checkbox"/> Bentonite <input type="checkbox"/> Concrete Depth: From <b>1.2</b> ft. to <b>23.0</b> ft.		
Sand, f. to med., coarser zones, some clay			16. Nearest source of possible contamination: ft. <input type="checkbox"/> Direction <input type="checkbox"/> Type <b>None</b> Well disinfected upon completion? <input type="checkbox"/> Yes <input type="checkbox"/> No		
Shale, Maroon. (Nippawalla Group)			17. Pump: <input checked="" type="checkbox"/> Not installed Manufacturer's name <input type="checkbox"/> Model number <input type="checkbox"/> HP <input type="checkbox"/> Volts <input type="checkbox"/> Length of drop pipe <input type="checkbox"/> ft. capacity <input type="checkbox"/> g.p.m. Type: <input type="checkbox"/> Submersible <input type="checkbox"/> Turbine <input type="checkbox"/> Jet <input type="checkbox"/> Reciprocating <input type="checkbox"/> Centrifugal <input type="checkbox"/> Other		
(Use a second sheet if needed)					
18. Elevation: <b>1718.7</b> Topography: <input type="checkbox"/> Hill <input checked="" type="checkbox"/> Slope <input type="checkbox"/> Upland <input type="checkbox"/> Valley	19. Remarks: <b>Well to be completed with pitless unit by Contractor</b>  <b>* Bentonite 22.5 to 23.0 Neat Cement 1.2 to 22.5</b>		20. Water well contractor's certification: This well was drilled under my jurisdiction and this report is true to the best of my knowledge and belief. <b>Kansas Dept. of Transportation</b> Business name <input type="checkbox"/> License No. <input type="checkbox"/> Address <b>Topeka, Kansas</b> Signed <b>[Signature]</b> Date <b>1/30/81</b> Authorized Representative		

Forward the white, blue and pink copies to the Department of Health and Environment

Form WWC-5