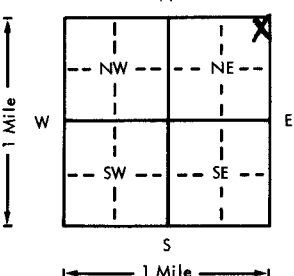
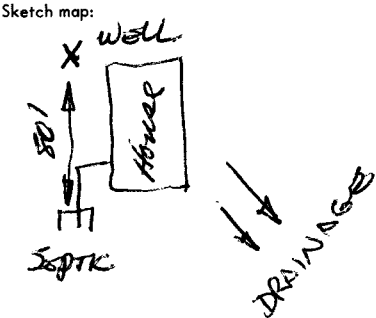


USE TYPEWRITER OR BALL
POINT PEN-PRESS FIRMLY,
PRINT CLEARLY.

WATER WELL RECORD
KSA 82a-1201-1215

Kansas Department of Health and
Environment-Division of Environment
(Water well Contractors)
Topeka, Kansas 66620

1. Location of well:	County Pratt	Fraction NE 1/4 NE 1/4 NE 1/4	Section number 35	Township number T 28	Range number S R 11 W E/W
2. Distance and direction from nearest town or city: 3 W & 5 S Street address of well location if in city: OF CUNNINGHAM, KS			3. Owner of well: Brenton Bortz R.R. or street: City, state, zip code: Cunningham, Kansas		
4. Locate with "X" in section below: 			Sketch map: 		
6. Bore hole dia. 10 in. Completion date 6 Sept 79 Well depth 100 ft.			7. <input checked="" type="checkbox"/> Cable tool <input checked="" type="checkbox"/> Rotary <input type="checkbox"/> Driven <input type="checkbox"/> Dug <input type="checkbox"/> Hollow rod <input type="checkbox"/> Jetted <input type="checkbox"/> Bored <input type="checkbox"/> Reverse rotary		
8. Use: <input checked="" type="checkbox"/> Domestic <input type="checkbox"/> Public supply <input type="checkbox"/> Industry <input type="checkbox"/> Irrigation <input type="checkbox"/> Air conditioning <input type="checkbox"/> Stock <input type="checkbox"/> Lawn <input type="checkbox"/> Oil field water <input type="checkbox"/> Other			9. Casing: Material <input type="checkbox"/> Height: <input checked="" type="checkbox"/> Above or below Threaded <input type="checkbox"/> Welded <input type="checkbox"/> Surface 12 in. RMP <input checked="" type="checkbox"/> PVC <input type="checkbox"/> Weight <input type="checkbox"/> lbs./ft. Dia. 5 in. to 80 ft. depth Wall Thickness: inches or Dia. <input type="checkbox"/> in. to <input type="checkbox"/> ft. depth gage No. 200		
5. Type and color of material			From	To	10. Screen: Manufacturer's name MODERN Type SLOT Dia. 5" Slot/gauze 1/16 Length 20' Set between 80 ft. and 100 ft. Gravel pack? YES Size range of material 1/4 X 3/8
Top soil			0	2	11. Static water level: 50 ft. below land surface Date 6 Sept 79
Clay, white and caliche			2	15	12. Pumping level below land surfaces: ft. after hrs. pumping g.p.m. ft. after hrs. pumping g.p.m. Estimated maximum yield 70 g.p.m.
Sand, fine to coarse & Med. gravel with some clay streaks			15	80	13. Water sample submitted: YES No Date
Sand, fine to coarse and coarse gravel			80	105	14. Well head completion: <input checked="" type="checkbox"/> Pitless adapter 12 inches above grade
Sand, fine to coarse & med. gravel			105	120	15. Well grouted? YES With: <input checked="" type="checkbox"/> Neat cement <input type="checkbox"/> Bentonite <input type="checkbox"/> Concrete Depth: From 4 ft. to 14 ft.
Clay, tan			120	135	16. Nearest source of possible contamination: ft. 80 Direction SOUTH Type SEPTIC Well disinfected upon completion? <input checked="" type="checkbox"/> Yes <input type="checkbox"/> No
(Use a second sheet if needed)					17. Pump: Not installed Manufacturer's name STA RITE Model number SR 20 HP 1 Volts 230 Length of drop pipe 75 ft. capacity 27 g.p.m. Type: <input checked="" type="checkbox"/> Submersible <input type="checkbox"/> Turbine <input type="checkbox"/> Jet <input type="checkbox"/> Reciprocating <input type="checkbox"/> Centrifugal <input type="checkbox"/> Other
18. Elevation:	19. Remarks: 4' x 4' x 4" slab Paired below pitless adapter		20. Water well contractor's certification: This well was drilled under my jurisdiction and this report is true to the best of my knowledge and belief. Central Well & Pump Inc. 325 Business name License No. Address P.O. Box 1032 Pratt, Kansas Signed [Signature] Date Oct 79 Authorized representative		

Forward the white, blue and pink copies to the Department of Health and Environment

Form WWC-5