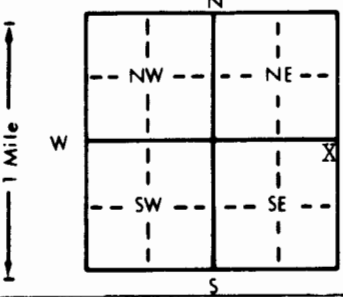


1 LOCATION OF WATER WELL:		Fraction	Section Number		Township Number	Range Number
County: Pratt		NE 1/4 NE 1/4 SE 1/4	8		T 28 S	R 12W E/W
Distance and direction from nearest town or city street address of well if located within city? 2 1/2 E, 1 S, 1 1/2 E of Pratt, Kansas						
2 WATER WELL OWNER: Steve Brown						
RR#, St. Address, Box #: P.O. Box 923						
City, State, ZIP Code: Pratt, Kansas 67124						
Board of Agriculture, Division of Water Resources						
Application Number: Unknown						
3 LOCATE WELL'S LOCATION WITH AN "X" IN SECTION BOX:		4 DEPTH OF COMPLETED WELL: 196 ft. ELEVATION: Unknown				
		Depth(s) Groundwater Encountered 1. 96 ft. 2. ft. 3. ft.				
		WELL'S STATIC WATER LEVEL 96 ft. below land surface measured on mo/day/yr 10/17/96				
		Pump test data: Well water was ft. after hours pumping gpm				
		Est. Yield 20 gpm: Well water was ft. after hours pumping gpm				
		Bore Hole Diameter 7 7/8 in. to 196 ft., and in. to ft.				
WELL WATER TO BE USED AS:						
1 Domestic 3 Feedlot 6 Oil field water supply 9 Dewatering 12 Other (Specify below)						
2 Irrigation 4 Industrial 7 Lawn and garden only 10 Monitoring well						
Was a chemical/bacteriological sample submitted to Department? Yes No If yes, mo/day/yr sample was submitted						
Water Well Disinfected? Yes No						
5 TYPE OF BLANK CASING USED:						
1 Steel 3 RMP (SR) 5 Wrought iron 8 Concrete tile CASING JOINTS: Glued Clamped						
2 PVC 4 ABS 6 Asbestos-Cement 9 Other (specify below) Welded						
3 Fiberglass Threaded						
Blank casing diameter 5 in. to 156 ft., Dia. in. to ft., Dia. in. to ft.						
Casing height above land surface 12 in., weight 2.8 lbs./ft. Wall thickness or gauge No. Sch. 40						
TYPE OF SCREEN OR PERFORATION MATERIAL:						
1 Steel 3 Stainless steel 5 Fiberglass 8 RMP (SR) 10 Asbestos-cement						
2 Brass 4 Galvanized steel 6 Concrete tile 9 ABS 11 Other (specify)						
12 None used (open hole)						
SCREEN OR PERFORATION OPENINGS ARE:						
1 Continuous slot 5 Gauzed wrapped 8 Saw cut 11 None (open hole)						
3 Mill slot 6 Wire wrapped 9 Drilled holes						
2 Louvered shutter 4 Key punched 7 Torch cut 10 Other (specify)						
SCREEN-PERFORATED INTERVALS: From 156 ft. to 196 ft., From ft. to ft.						
From ft. to ft., From ft. to ft.						
GRAVEL PACK INTERVALS: From 20 ft. to 196 ft., From ft. to ft.						
From ft. to ft., From ft. to ft.						
6 GROUT MATERIAL:						
1 Neat cement 2 Cement grout 3 Bentonite 4 Other						
Grout Intervals: From 0 ft. to 20 ft., From ft. to ft., From ft. to ft.						
What is the nearest source of possible contamination:						
1 Septic tank 4 Lateral lines 7 Pit privy 10 Livestock pens 14 Abandoned water well						
2 Sewer lines 5 Cess pool 8 Sewage lagoon 11 Fuel storage 15 Oil well/Gas well						
3 Watertight sewer lines 6 Seepage pit 9 Feedyard 12 Fertilizer storage 16 Other (specify below)						
13 Insecticide storage Abandoned corral 65						
Direction from well? SW How many feet? 65						
LITHOLOGIC LOG						
FROM	TO		FROM	TO	PLUGGING INTERVALS	
0	4	Top soil				
4	10	Sand and gravel				
10	80	Clay				
80	140	Fine sand				
140	196	Sand and gravel				
7 CONTRACTOR'S OR LANDOWNER'S CERTIFICATION: This water well was (1) constructed, (2) reconstructed, or (3) plugged under my jurisdiction and was completed on (mo/day/year) 10/17/96 and this record is true to the best of my knowledge and belief. Kansas						
Water Well Contractor's License No. 186 This Water Well Record was completed on (mo/day/yr) 10/21/96						
under the business name of Kelly's Water Well Service, Inc. by (signature) Kevin Good						
INSTRUCTIONS: Use typewriter or ball point pen. PLEASE PRESS FIRMLY and PRINT clearly. Please fill in blanks, underline or circle the correct answers. Send top three copies to Kansas Department of Health and Environment, Bureau of Water, Topeka, Kansas 66620-0001. Telephone: 913-296-5545. Send one to WATER WELL OWNER and retain one for your records.						

OFFICE USE ONLY

T

R

E/W

SEC.

1/4

1/4

1/4