

1] LOCATION OF WATER WELL:	Fraction	Section Number	Township Number	Range Number
County: <u>PRATT</u>	<u>NW</u> $\frac{1}{4}$ <u>NE</u> $\frac{1}{4}$ <u>NW</u> $\frac{1}{4}$	<u>1</u>	T <u>28</u> S	R <u>12</u> <u>EW</u>

Distance and direction from nearest town or city street address of well if located within city?

1 1/2 MILES WEST OF CAIRO KS, ON THE SOUTH SIDE OF HWY 542] WATER WELL OWNER: DAVE & ANITA TWINERRR#, St. Address, Box # : 80233 E. 54 HWY

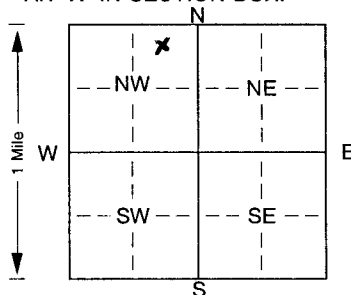
Board of Agriculture, Division of Water Resources

City, State, ZIP Code : PRATT KS 67124

Application Number:

3] LOCATE WELL'S LOCATION WITH 4] DEPTH OF COMPLETED WELL. 45' ft. ELEVATION:

AN "X" IN SECTION BOX:

Depth(s) Groundwater Encountered 1. 13 ft. 2. ft. 3. ft.WELL'S STATIC WATER LEVEL 13 ft. below land surface measured on mo/day/yrPump test data: Well water was 14 ft. after 3 hours pumping 20 gpmEst. Yield 25 gpm: Well water was ft. after hours pumping gpmBore Hole Diameter. 9 3/8 in. to 45' ft., and. in. to ft.

WELL WATER TO BE USED AS: 5 Public water supply 8 Air conditioning 11 Injection well

1 Domestic 3 Feedlot 6 Oil field water supply 9 Dewatering 12 Other (Specify below)

2 Irrigation 4 Industrial 7 Domestic (lawn & garden) 10 Monitoring well

Was a chemical/bacteriological sample submitted to Department? Yes. No. X; If yes, mo/day/yr sample was submittedWater Well Disinfected? Yes X No5] TYPE OF BLANK CASING USED: 5 Wrought iron 8 Concrete tile CASING JOINTS: Glued. X Clamped.

1 Steel 3 RMP (SR) 6 Asbestos-Cement 9 Other (specify below) Welded

2 PVC 4 ABS 7 Fiberglass Threaded.Blank casing diameter 5 in. to 30' ft., Dia. in. to ft., Dia. in. to ft.Casing height above land surface. 14 in., weight lbs./ft. Wall thickness or gauge No. SC4 160

TYPE OF SCREEN OR PERFORATION MATERIAL:

1 Steel 3 Stainless steel 5 Fiberglass 7 PVC 10 Asbestos-cement

2 Brass 4 Galvanized steel 6 Concrete tile 8 RMP (SR) 11 Other (specify)

SCREEN OR PERFORATION OPENINGS ARE: 5 Gauzed wrapped 8 Saw cut 11 None (open hole)

1 Continuous slot 3 Mill slot 6 Wire wrapped 9 Drilled holes

2 Louvered shutter 4 Key punched 7 Torch cut 10 Other (specify) ft.

SCREEN-PERFORATED INTERVALS: From 45' ft. to 30' ft., From ft. to ft.

From ft. to ft., From ft. to ft.

GRAVEL PACK INTERVALS: From 45' ft. to 25' ft., From ft. to ft.

From ft. to ft., From ft. to ft.

6] GROUT MATERIAL: 1 Neat cement 2 Cement grout 3 Bentonite 4 OtherGrout Intervals: From 25' ft. to 0' ft., From ft. to ft., From ft. to ft.

What is the nearest source of possible contamination:

1 Septic tank 4 Lateral lines 7 Pit privy 10 Livestock pens 14 Abandoned water well

2 Sewer lines 5 Cess pool 8 Sewage lagoon 11 Fuel storage 15 Oil well/Gas well

3 Watertight sewer lines 6 Seepage pit 9 Feedyard 12 Fertilizer storage 16 Other (specify below)

Direction from well? NORTH How many feet? 120'

FROM TO LITHOLOGIC LOG FROM TO PLUGGING INTERVALS

0 2' TOP SOIL2' 6' SAND & SILT FINE6' 10' TAN CLAY10' 15' CLAY TAN TO ORANGE GREENSAND & GRAVEL15' 20' VERY FINE SAND20' 30' SAND VERY FINE TO COARSESOME SMALL TO MEDIUM GRAVELTHIN CLAY STREAKS30' 45' VERY FINE SAND & LITTLEMEDIUM GRAVEL & CLAY7] CONTRACTOR'S OR LANDOWNER'S CERTIFICATION: This water well was (1) constructed, (2) reconstructed, or (3) plugged under my jurisdiction and wascompleted on (mo/day/year) 7-6-01 and this record is true to the best of my knowledge and belief. KansasWater Well Contractor's Licence No. 665 This Water Well Record was completed on (mo/day/yr) 8-6-01under the business name of PRATT WELL ENVIRONMENTAL by (signature) STEVEN E. EYLL